

LINCOLN
 D 2003
 7-23-81

MISSISSIPPI
 BOARD OF WATER COMMISSIONERS
 416 North State Street
 Jackson, Mississippi 39201

WATER WELL DRILLERS LOG

July 23, 1981 Grenn Water Well Cont. Lincoln
 date well completed firm name county well located

LANDOWNER: J. E. Diamond
 Route 6
 Brookhaven, Miss.
 (mailing address)

description of formations encountered
 Citronelle
 from 1 to 140

WELL LOCATION:
 sec. 27 T. 8 N R. 8 E
 4 miles NE of Brookhaven
 (distance) (direction) (nearest town)

(empty grid space)

WELL PURPOSE: home
 (home, irrigation, municipal, industrial)

(empty grid space)

WELL COMPLETION DATA:
 (1) diameter (inches) 4
 (2) total depth (feet) 140
 (3) static water level (feet) 75 below top of ground.
 (4) casing PVC 130'
 (material) (depth)
 4" if telescope see back.
 (size)
 (5) screen 10' 130'
 (length) (depth to top)
 .010 PVC
 (size) (material)
 (6) pump 1/2 sub 8
 (HP) (yield gpm)
 electricity
 (type power)
 (7) electric log no
 (yes or no)
 (organization running log)

(empty grid space)

(8) how well bottom plugged back wash valve


DEPT. OF NATURAL RESOURCES
 BUREAU OF LAND & WATER RESOURCES
 AUG 14 1981

DRILLERS REMARKS:

RECEIVED

If well telescopes please sketch and show depths.

GROUND LEVEL

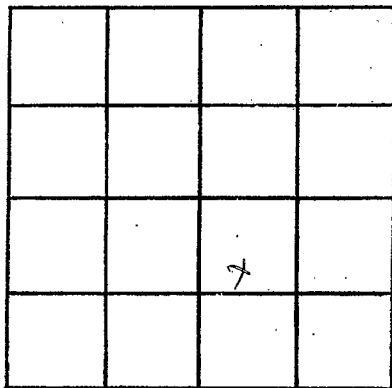

SECTION 27

Please indicate well location X.

ADDITIONAL INFORMATION

If more than one screen,
show locations of each on sketch.