

Lincoln  
D 2065  
7-15-80

MISSISSIPPI  
BOARD OF WATER COMMISSIONERS  
416 North State Street  
Jackson, Mississippi 39201

WATER WELL DRILLERS LOG

July 15 1980 Grenn Water Well Cont. Lincoln  
date well completed firm name county well located

LANDOWNER:  
James Williams  
2708 Brignall Road.  
Brookhaven, Ms.  
(mailing address)

description of formations encountered	from	to
Citronelle	1	84

WELL LOCATION:  
sec. 31 T 8 N R 8 E  
2 N Brookhaven  
(distance) miles (direction) of (nearest town)

WELL PURPOSE: home  
(home, irrigation, municipal, industrial)


- WELL COMPLETION DATA:
- (1) diameter (inches) 4
  - (2) total depth (feet) 84
  - (3) static water level (feet) 51 below top of ground.
  - (4) casing PVC 74 (material), (depth) 4" (size) If telescope see back.
  - (5) screen 10' 74' (length), (depth to top) .010 PVC (size), (material) did not install
  - (6) pump (HP) (yield gpm)
  - (type power)
  - (7) electric log no (yes or no)
  - (organization running log)
  - (8) how well bottom plugged backwash valve

DEPT. OF NATURAL RESOURCES  
BUREAU OF LAND & WATER RESOURCES  
OCT 23 1980  
RECEIVED

DRILLERS REMARKS:

If well telescopes please sketch and show depths.

GROUND LEVEL

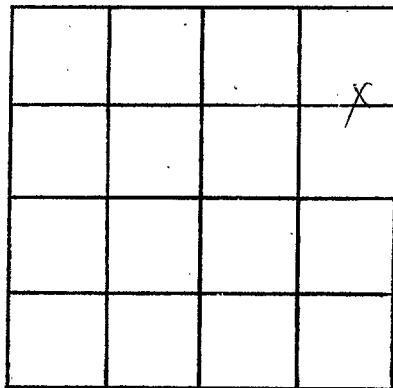

SECTION 31

Please indicate well location X.

ADDITIONAL INFORMATION

If more than one screen, show locations of each on sketch.