

MISSISSIPPI DEPARTMENT OF NATURAL RESOURCES

Bureau of Land and Water Resources

Southport Mall

P.O. Box 10631

Jackson, Mississippi 39209

WATER WELL DRILLERS LOG

Lincoln  
D  
2007

3-3

19

86 F. J. G. & Co. Well Serv

firm name

Lincoln

county well located

LANDOWNER:

Martin Rollins

P.O. Box Gulfport, ms.  
(mailing address)

description of formations encountered

from

to

Chalk

0 22

Fine Sand

22 70

Coarse Sand & Gravel

70 90

WELL LOCATION:

sec. 32 T 8 N R 8 E  
S W  
1 miles NE of Brookhaven  
(distance) (direction) (nearest town)

WELL PURPOSE: Monitor  
(home, irrigation, municipal, industrial)

WELL COMPLETION DATA:

- (1) diameter (inches) 4
- (2) total depth (feet) 90
- (3) static water level (feet) 68 (below above top of ground)
- (4) casing PVC 75 (material) (depth)  
4 (size) if telescope see back.
- (5) screen 15 75 (length) (depth to top)  
4 (size) PVC (material)
- (6) pump UNK UNK (HP) (yield gpm)  
UNK (type power)
- (7) electric log No (yes or no)  
(organization running log)
- (8) how well bottom plugged Sand Plug


RECEIVED  
MAR 13 1986

Department of Natural Resources  
Bureau of Land & Water Resources

DRILLERS REMARKS:

If well telescopes please sketch and show depths.

GROUND LEVEL

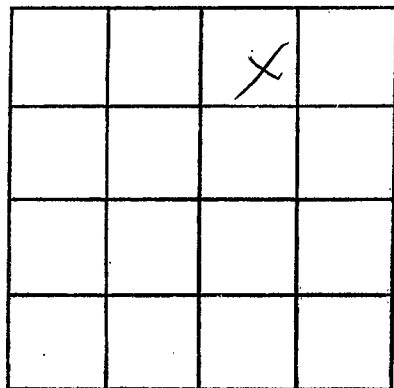

SECTION 32

Please indicate well location X.

ADDITIONAL INFORMATION

If more than one screen,  
show locations of each on sketch.