

MISSISSIPPI DEPARTMENT OF NATURAL RESOURCES

Bureau of Land and Water Resources

Southport Mall

P.O. Box 10631

Jackson, Mississippi 39209

WATER WELL DRILLERS LOG

LINCOLN
D
2008

6-12-1986 date well completed      86 Fitzgerald well Section firm name      Lincoln county well located

LANDOWNER:	description of formations encountered	from	to
Martin Rollins P.O. Box Brookhaven (mailing address)			
WELL LOCATION:			
sec 32 T 8 N R 8 E 14 Brookhaven IND. PARK W 1 miles N of Brookhaven (distance) (direction) (nearest town)			
WELL PURPOSE: (home, irrigation, municipal, industrial)			
WELL COMPLETION DATA:			
(1) diameter (inches) 4			
(2) total depth (feet) 90			
(3) static water level (feet) 68 below top of ground.			
(4) casing PVC, 74 (depth) 4 (size) if telescope see back.			
(5) screen 16 (length), 74 (depth to top) 4 (size), PVC (material)			
(6) pump 1/3 (HP), 8 (yield gpm) Elee (type power)			
(7) electric log No (yes or no) (organization running log)			
(8) how well bottom plugged Sand Shovel			
DRILLERS REMARKS:			




JUL 21 1986

Department of Natural Resources  
Bureau of Land & Water Resources

If well telescopes please sketch and show depths.

GROUND LEVEL

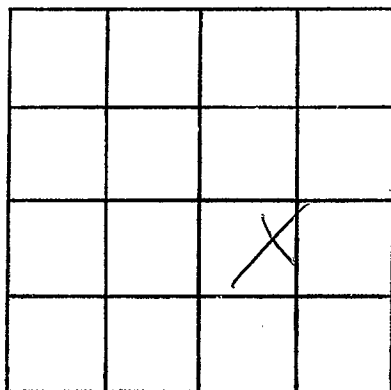

SECTION 52

Please indicate well location X.

ADDITIONAL INFORMATION

If more than one screen,  
show locations of each on sketch.