

MISSISSIPPI DEPARTMENT OF ENVIRONMENTAL QUALITY
Office of Land and Water Resources

P. O. Box 10631
Jackson, MS 39289-0631
WATER WELL DRILLERS LOG

COUNTY WELL LOCATED <u>Lincoln</u>	
WELL NUMBER <u>D 2019</u>	CODED
DATE WELL COMPLETED <u>12-12-96</u>	

PERMIT NUMBER
NAME OF DRILLING FIRM <u>Green Water Well & Supply</u>

NAME & MAILING ADDRESS OF LANDOWNER <u>Susan Davis</u>		
<u>1091 Somerset SE</u>		
<u>Boque Chitto MS 39629</u>		
WELL LOCATION: SEC	TOWNSHIP	RANGE
<u>5</u>	<u>5</u>	<u>8</u>
DISTANCE DIRECTION NEAREST TOWN <u>2</u> Miles <u>E</u> of <u>Boque Chitto</u>		
OTHER LANDMARK		
WELL PURPOSE (Home) Irrigation, Municipal, Industrial, Fish Pond, etc.		

PUMP DATA		
PUMP TYPE (Circle One): <input checked="" type="checkbox"/> Submersible Turbine Jet Flowing Well, Other (Describe) _____		
POWER TYPE (Circle One): <input checked="" type="checkbox"/> Electric Tractor Diesel Gasoline <u>1</u> Butane, Other (Describe) _____ H/P <u>2</u>		
Pump Capacity (GPM)	No. of Stages	Setting Depth
<u>10</u>	<u>9</u>	<u>90</u> FT.
PUMP TEST		
Well yielded <u>10</u> GPM with a drawdown of <u>0</u> ft. after <u>1</u> hours of pumping		

WELL DATA		
Well Depth <u>98</u>	Casing Diameter (In.) <u>4</u>	Casing Length (Ft.) <u>88</u>
Type of Casing <u>PVC</u>	Hole Depth <u>107</u>	Depth to Static Water Level <u>60</u>
TYPE OF COMPLETION: (Circle One or More): <input checked="" type="checkbox"/> Gravel Packed Underreamed Telescoped Natural Development Open Hole Other (Describe) _____		
WELL GROUTED TO A DEPTH OF <u>5</u> FEET Type Grout (circle one): Cement, Bentonite, or <input checked="" type="checkbox"/> Mix		

LOG DATA	
TYPE OF LOG RUN (Circle One): <input checked="" type="checkbox"/> No Log Run Electric, Gamma Ray, Density, Sonic, Neutron, Other (Describe) _____	
Name of Organization Running Log	

SCREEN DATA		
Diameter - Inches <u>4</u>	Length - Feet <u>10</u>	Slot Size - Inches <u>.010</u>
Screen Type <u>PVC</u>	Depth to Bottom - Feet <u>98</u>	

GEOLOGIC DATA (Office Use Only)			
Surface Elev.	Geologic Unit	Unit Thickness	Depth to Top
Subs. SWL	Date	Analysis	Aquifer Test
Driller's Remarks			
Top of Lap Pipe or Reduction in Casing			
FEET	IF TELESCOPED OR MORE THAN ONE SCREEN: USE BACK PAGE		

DESCRIPTION OF FORMATIONS ENCOUNTERED	FROM	TO
<u>Red Clay</u>	<u>0</u>	<u>18</u>
<u>Sand & Gravel</u>	<u>18</u>	<u>107</u>

FORMATIONS (Continued)	FROM	TO


RECEIVED
FEB 07 1997

Dept. of Environmental Quality
Office of Land & Water Resources

IF MORE SPACE IS NEEDED, USE BACK

If well telescopes please
sketch and show depths.

GROUND LEVEL

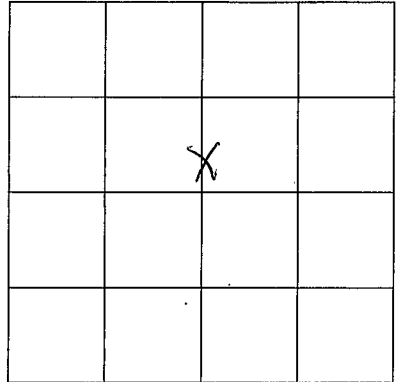

SECTION 5

Please indicate well location X.

ADDITIONAL INFORMATION

If more than one screen,
show location of each on sketch.