

**MISSISSIPPI DEPARTMENT OF ENVIRONMENTAL QUALITY**

Office of Land and Water Resources

P. O. Box 10631  
Jackson, MS 39289-0631  
**WATER WELL DRILLERS LOG**

COUNTY WELL LOCATED <i>Leflore</i>	
WELL NUMBER <i>D 2025</i>	CODED
DATE WELL COMPLETED <i>8-2-98</i>	

<b>Green Water Well &amp; Supply</b> 1318 Pricedale Dr. SE Bogue Chitto, MS 39629
<small>NAME OF DRILLING FIRM</small>

NAME & MAILING ADDRESS OF LANDOWNER <i>Sammy Holmes</i>		
<i>537 Hwy 583 SE</i>		
<i>Brookhaven</i>		
WELL LOCATION: SEC	TOWNSHIP	RANGE
<i>24</i>	<i>8 N S</i>	<i>8 E W</i>
DISTANCE	DIRECTION	NEAREST TOWN
<i>5</i> Miles	<i>NE</i>	of <i>Brookhaven</i>
OTHER LANDMARK		
WELL PURPOSE: <input checked="" type="radio"/> Home, Irrigation, Municipal, Industrial, Fish Pond, etc.		

<b>PUMP DATA</b>		
PUMP TYPE (Circle One): <input checked="" type="radio"/> Submersible, Turbine, Jet, Flowing Well, Other (Describe) _____		
POWER TYPE (Circle One): <input checked="" type="radio"/> Electric, Tractor, Diesel, Gasoline, Butane, Other (Describe) _____ H/P <i>1 1/2</i>		
Pump Capacity (GPM) <i>25</i>	No. of Stages <i>10</i>	Setting Depth <i>125</i> FT.
PUMP TEST		
Well yielded <i>25</i> GPM with a drawdown of <i>0</i> ft. after <i>1</i> hours of pumping		

<b>WELL DATA</b>		
Well Depth <i>205'</i>	Casing Diameter (In.) <i>4"</i>	Casing Length (Ft.) <i>195'</i>
Type of Casing <i>PVC</i>	Hole Depth <i>230'</i>	Depth to Static Water Level <i>85'</i>
TYPE OF COMPLETION: (Circle One or More): <input checked="" type="radio"/> Gravel Packed, <input type="radio"/> Underreamed, <input type="radio"/> Telescoped, <input type="radio"/> Natural Development, <input type="radio"/> Open Hole, <input type="radio"/> Other (Describe) _____		

<b>LOG DATA</b>	
TYPE OF LOG RUN (Circle One): <input type="radio"/> Electric, Gamma Ray, Density, Sonic, Neutron, Other (Describe) _____ <input checked="" type="radio"/> No Log Run	
Name of Organization Running Log	

WELL GROUTED TO A DEPTH OF <i>10</i> FEET
Type Grout (circle one): Cement, Bentonite, or <input checked="" type="radio"/> <i>Mix</i>

<b>GEOLOGIC DATA (Office Use Only)</b>			
Surface Elev.	Geologic Unit	Unit Thickness	Depth to Top
Subs. SWL	Date	Analysis	Aquifer Test
Driller's Remarks			
Top of Lap Pipe or Reduction in Casing			
FEET		IF TELESCOPED OR MORE THAN ONE SCREEN: USE BACK PAGE	

<b>SCREEN DATA</b>		
Diameter - Inches <i>4"</i>	Length - Feet <i>10'</i>	Slot Size - Inches <i>.010</i>
Screen Type <i>PVC</i>	Depth to Bottom - Feet <i>205'</i>	

DESCRIPTION OF FORMATIONS ENCOUNTERED	FROM	TO
<i>Red Clay</i>	<i>0</i>	<i>5</i>
<i>White Clay</i>	<i>5</i>	<i>30</i>
<i>Blue Clay</i>	<i>30</i>	<i>172</i>
<i>Sand</i>	<i>172</i>	<i>207</i>
<i>Streaky</i>	<i>207</i>	<i>230</i>

FORMATIONS (Continued)	FROM	TO
<b>RECEIVED</b>		
<b>JAN 25 1999</b>		
Dept. of Environmental Quality Office of Land & Water Resources		

IF MORE SPACE IS NEEDED, USE BACK

If well telescopes please sketch and show depths.


GROUND LEVEL

		X	

SECTION 24

Please indicate well location X.

ADDITIONAL INFORMATION

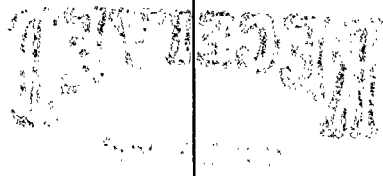

If more than one screen,  
show location of each on sketch.