

MISSISSIPPI
BOARD OF WATER COMMISSIONERS
416 North State Street
Jackson, Mississippi 39201

CODED

WATER WELL DRILLERS LOG

LINCOLN
E3
6-3-71

6-3-1971 date well completed
Green Water Well Co. firm name
Lincoln county well located

LANDOWNER:
Jed Mc Gee
Sontag, Miss.
(mailing address)

description of formations encountered	from	to
Hattiesburg	0	80
Sand	80	100
Clay	100	120

WELL LOCATION:
sec 24 T 8 N R 9 E
12 miles NE of Brookhaven
(distance) (direction) (nearest town)

WELL PURPOSE: home
(home, irrigation, municipal, industrial)

WELL COMPLETION DATA:

(1) diameter (inches) 6

(2) total depth (feet) 120

(3) static water level (feet) 60 below top of ground.

(4) casing PVC 94 (material) (depth)
4 (size) If telescope see back.

(5) screen 6' 94 (length) (depth to top)
.010 PVC (size) (material)

(6) pump 3 HP sub 7 (HP) (yield gpm)
electric (type power)

(7) electric log no (yes or no)

(organization running log)

(8) how well bottom plugged Wood

CODED


JAN 21 1971

DRILLERS REMARKS:

MISS. ED. OF
WATER COM.

If well telescopes please sketch and show depths.

GROUND LEVEL

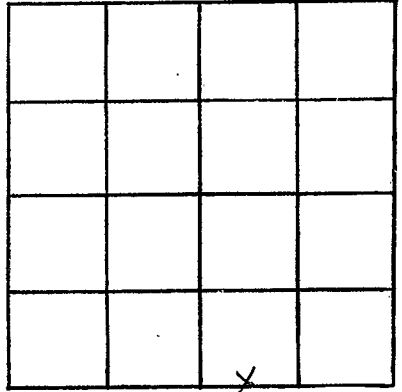

SECTION 24

Please indicate well location X.

ADDITIONAL INFORMATION

If more than one screen,
show locations of each on sketch.