

MISSISSIPPI
BOARD OF WATER COMMISSIONERS
416 North State Street
Jackson, Mississippi 39201

CODED

WATER WELL DRILLERS LOG

LINCOLN
E 4
6-9-71

6-4 1971 Green Water Well Co. Lincoln
date well completed firm name county well located

LANDOWNER:
Clyde Rushing
Sontag
(mailing address)

description of formations encountered	from	to
<u>Hallsburg</u>	<u>0</u>	<u>140</u>
<u>Sand</u>	<u>140</u>	<u>175</u>
<u>Clay</u>	<u>175</u>	<u>200</u>

WELL LOCATION:
sec. 24T 8^D_S R. 9^E_W
12 miles NE of Brookhaven
(distance) (direction) (nearest town)

WELL PURPOSE: Home
(home, irrigation, municipal, industrial)

- WELL COMPLETION DATA:
- (1) diameter (inches) 6
 - (2) total depth (feet) 200
 - (3) static water level (feet) 40 below top of ground.
 - (4) casing PVC, 163
(material) (depth)
 if telescope see back.
(size)
 - (5) screen 6', 163
(length) (depth to top)
.010, PVC
(size) (material)
 - (6) pump Did not
(HP) (yield gpm)
install
(type power)
 - (7) electric log no
(yes or no)

(organization running log)
 - (8) how well bottom plugged Wood


CODED

JUL 21 1971

DRILLERS REMARKS:

If well telescopes please sketch and show depths.

GROUND LEVEL

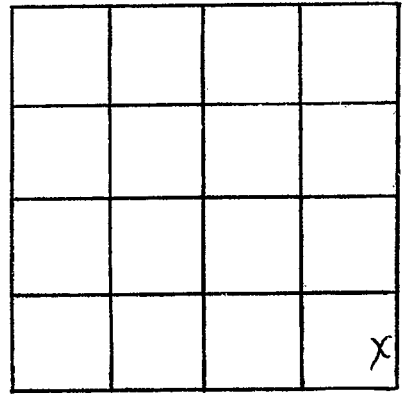

SECTION 24

Please indicate well location X.

ADDITIONAL INFORMATION

A series of horizontal lines for writing additional information.

If more than one screen, show locations of each on sketch.