

**LINCOLN**  
**E 5**  
**9-29-73**

MISSISSIPPI  
BOARD OF WATER COMMISSIONERS  
416 North State Street  
Jackson, Mississippi 39201

**CODED**

**WATER WELL DRILLERS LOG**

79 Sept. 1973 Amos Park Well Sinc Lincoln  
date well completed firm name county well located

**LANDOWNER:**  
Clyde Rushing  
Brookline  
(mailing address)

description of formations encountered	from	to
<u>dry</u>	<u>0</u>	<u>20</u>
<u>bank shale</u>	<u>20</u>	<u>35</u>
<u>clay sand</u>	<u>35</u>	<u>50</u>
<u>cherty</u>	<u>50</u>	<u>240</u>
<u>sand</u>	<u>240</u>	<u>274</u>

**WELL LOCATION:**  
sec. 31 T 8 N R 9 E  
12 miles N.E. of Brookline  
(distance) (direction) (nearest town)

**WELL PURPOSE:**  
(home, irrigation, municipal, industrial)

**WELL COMPLETION DATA:**

(1) diameter (inches) 4

(2) total depth (feet) 274

(3) static water level (feet) 10 below top of ground

(4) casing 1 (material), 262 (depth)  
if telescope see back.  
(size)

(5) screen 12 (length), 262 (depth to top)  
4 (size), PI (material)

(6) pump 1/2 (HP), 5 (yield gpm)  
flat (type power)

(7) electric log (yes or no) \_\_\_\_\_  
(organization running log) \_\_\_\_\_

(8) how well bottom plugged wood


**CODED**

**DRILLERS REMARKS:**

**OCT 24 1973**

If well telescopes please sketch and show depths.

GROUND LEVEL

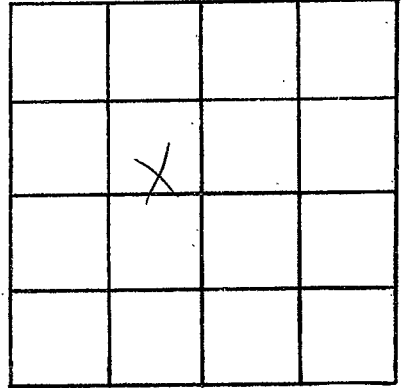

SECTION 31

Please indicate well location X.

ADDITIONAL INFORMATION

If more than one screen,  
show locations of each on sketch.