

LINCOLN

~~COPAH~~

E6

10/9/78

MISSISSIPPI  
BOARD OF WATER COMMISSIONERS  
416 North State Street  
Jackson, Mississippi 39201

CODED

WATER WELL DRILLERS LOG

LINCOLN

10/8/78 Griner Drilling Service Copiah

date well completed

firm name

county well located

LANDOWNER:

Texaco Oil Company  
1111 Rust  
Houston, Texas 77052  
(mailing address)

description of formations  
encountered

from

to

CLAY

0 63

Clay and sand

63 126

Sand on top  
then clay

126 147

Clay with little  
sand

147 435

Sand  
CODED

436 480

WELL LOCATION:

sec. 5 T 8 N R 9 E  
S W  
east of Wesson  
(distance) miles (direction) of (nearest town)

WELL PURPOSE: oil field supply  
(home, irrigation, municipal, industrial)

WELL COMPLETION DATA:

(1) diameter (inches) 4"  
(2) total depth (feet) 480'

(3) static water level (feet) 100 below  
top of ground.

(4) casing 4" steel 480'  
(material) (depth)

4" if telescope see back.  
(size)

(5) screen 42' 438'  
(length) (depth to top)  
4" perforated  
(size) (material)

(6) pump 80  
(HP) (yield gpm)  
AC  
(type power)

(7) electric log  
(yes or no)  
(organization running log)

(8) how well bottom plugged orange  
peel

1732' S + 1500' E of NW cor.


DRILLERS REMARKS:

REGISTERED  
OCT 19 1978

MISS. BD. OF WATER COMMISSIONERS

If well telescopes please sketch and show depths.

GROUND LEVEL

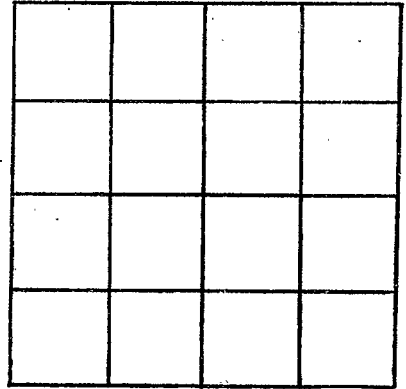

SECTION \_\_\_\_\_

Please indicate well location X.

ADDITIONAL INFORMATION

If more than one screen,  
show locations of each on sketch.