

LINCOLN  
E 2000  
5/3/77

MISSISSIPPI  
 BOARD OF WATER COMMISSIONERS  
 416 North State Street  
 131 Jackson, Mississippi 39201

WATER WELL DRILLERS LOG

May 3, 1977 Green Water Well Cont. Lincoln  
 date well completed firm name county well located


LANDOWNER: James Byrd Wesson, Miss.	description of formations encountered	from	to
	Clay	1	8
	sand	8	22
	white clay	22	61
	blue clay	61	253
	sand	253	282
(mailing address)			
<b>WELL LOCATION:</b>			
sec <u>26</u> T <u>8</u> <u>N</u> R <u>9</u> <u>E</u>			
<u>11</u> miles <u>NE</u> of <u>Brookhaven</u>			
(distance) (direction) (nearest town)			
<b>WELL PURPOSE:</b> <u>home</u> (home, irrigation, municipal, industrial)			
<b>WELL COMPLETION DATA:</b>			
(1) diameter (inches) <u>6</u>			
(2) total depth (feet) <u>282</u>			
(3) static water level (feet) <u>200</u> <u>below</u> top of ground.			
(4) casing <u>PVC</u> , <u>270</u> (material) (depth) <u>4"</u> (size) If telescope see back.			
(5) screen <u>12'</u> , <u>270'</u> (length) (depth to top) <u>.010</u> <u>PVC</u> (size) (material)			
(6) pump <u>1 sub</u> <u>10</u> (HP) (yield gpm) <u>electricity</u> (type power)			
(7) electric log <u>no</u> (yes or no)			
(organization running log)			
(8) how well bottom plugged <u>back wash valve</u>			
DRILLERS REMARKS:			

**RECEIVED**  
 JUN 14 1977

MISS. Bd. OF WATER COMMISSIONERS

If well telescopes please sketch and show depths.

GROUND LEVEL

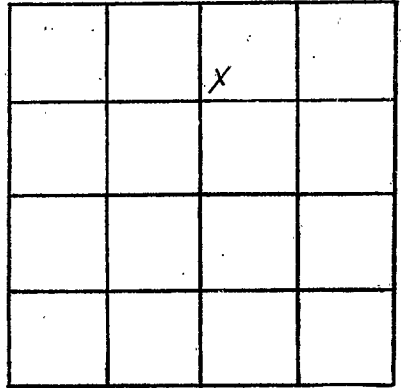

SECTION 26

Please indicate well location X.

ADDITIONAL INFORMATION

If more than one screen, show locations of each on sketch.