

Lincoln
E 200
3-20-80

MISSISSIPPI
BOARD OF WATER COMMISSIONERS
416 North State Street
Jackson, Mississippi 39201

WATER WELL DRILLERS LOG

3-20 1980 Grenn Water Well Cont. Lincoln
date well completed firm name county well located

LANDOWNER: Versie McGee
route 1, Box 286
Sontag, Ms. 39665
(mailing address)

description of formations encountered	from	to
Clay Gravel	1	5
white clay	5	60
blue clay	60	190
fine sand	190	210
blue clay	210	270
sand	270	365

WELL LOCATION:
sec. 24 T. 8 N. R. 9 E
S W
11 miles NE of Brookhaven
(distance) (direction) (nearest town)

WELL PURPOSE: home
(home, irrigation, municipal, industrial)

WELL COMPLETION DATA:
(1) diameter (inches) 4
(2) total depth (feet) 365
(3) static water level (feet) 125 below top of ground.
(4) casing PVC 355
(material) (depth)
4" If telescope see back.
(size)
(5) screen 10' 355'
(length) (depth to top)
.010" PVC
(size) (material)
(6) pump 3/4 sub 8
(HP) (yield gpm)
electricity
(type power)
(7) electric log no
(yes or no)

(organization running log)


(8) how well bottom plugged
backwash valve

DRILLERS REMARKS:

DEPT. OF NATURAL RESOURCES
BUREAU OF LAND & WATER RESOURCES
APR 29 1980
RECEIVED

If well telescopes please sketch and show depths.

GROUND LEVEL

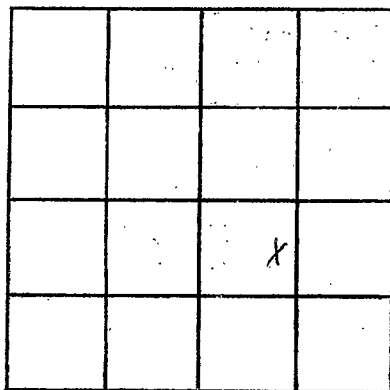

SECTION 24

Please indicate well location X.

ADDITIONAL INFORMATION

If more than one screen,
show locations of each on sketch.