

LINCOLN
E 2003
12-11-80

MISSISSIPPI
 BOARD OF WATER COMMISSIONERS
 416 North State Street
 Jackson, Mississippi 39201

WATER WELL DRILLERS LOG

Dec. 11 19 80 Green Water Well Cont. Lincoln
 date well completed firm name county well located

LANDOWNER: Floreen Martin
Route 2, Box 95 A
Wesson, Miss.
 (mailing address)

description of formations encountered	from	to
White clay	1	30
blue clay	30	95
fine sand	95	120
blue clay	120	180
sand	180	210

WELL LOCATION:
 1 sec. 8 T. 8 N. R. 9 W.
10 miles NE of Brookhaven
 (distance) (direction) (nearest town)

WELL PURPOSE: home
 (home, irrigation, municipal, industrial)

WELL COMPLETION DATA:
 (1) diameter (inches) 4
 (2) total depth (feet) 210
 (3) static water level (feet) 45 below above top of ground.
 (4) casing PVC, 200
 (material) (depth)
4" if telescope see back.
 (size)
 (5) screen 10', 200'
 (length) (depth to top)
.010, PVC
 (size) (material)
 (6) pump 1/2 sub, 8
 (HP) (yield gpm)
electricity
 (type power)
 (7) electric log no
 (yes or no)
 (organization running log)

(8) how well bottom plugged backwash valve


DRILLERS REMARKS:

DEPT. OF NATURAL RESOURCES
 BUREAU OF LAND AND WATER

JAN 20 1981
 RECEIVED

If well telescopes please sketch and show depths.

GROUND LEVEL

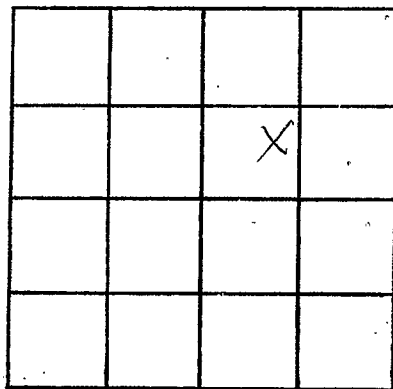

SECTION 1

Please indicate well location X.

ADDITIONAL INFORMATION

Lined area for additional information.

If more than one screen, show locations of each on sketch.