

Lincoln  
 E 2004  
 4-4-81

MISSISSIPPI  
 BOARD OF WATER COMMISSIONERS  
 416 North State Street  
 Jackson, Mississippi 39201

WATER WELL DRILLERS LOG

April 4 1981 Grenn Water Well Cont. Lincoln  
 date well completed firm name county well located

LANDOWNER: Donald Walley  
 Brookhaven, Ms.  
 (mailing address)

| description of fomations encountered | from | to  |
|--------------------------------------|------|-----|
| White clay                           | 1    | 35  |
| blue clay                            | 35   | 150 |
| fine sand                            | 150  | 165 |
| blue clay                            | 165  | 255 |
| sand                                 | 255  | 280 |

WELL LOCATION:  
 sec. 35 T 8 N R 9 E  
 9 NE Brookhaven  
 (distance) miles (direction) of (nearest town)

WELL PURPOSE: home  
 (home, irrigation, municipal, industrial)

- WELL COMPLETION DATA:
- (1) diameter (inches) 4
  - (2) total depth (feet) 280
  - (3) static water level (feet) 150 below top of ground.
  - (4) casing PVC 270  
 (material) (depth)  
 4" if telescope see back.  
 (size)
  - (5) screen 10' 270'  
 (length) (depth to top)  
 .010 (size) (material)
  - (6) pump 1HP Sub 8  
 (HP) (yield gpm)  
 electricity  
 (type power)
  - (7) electric log no  
 (yes or no)
- (organization running log)

(8) how well bottom plugged back wash valve

DRILLERS REMARKS:


DEPT. OF NATURAL RESOURCES  
 BUREAU OF LAND & WATER RESOURCES

JUN 5 - 1981

RECEIVED

If well telescopes please sketch and show depths.

GROUND LEVEL

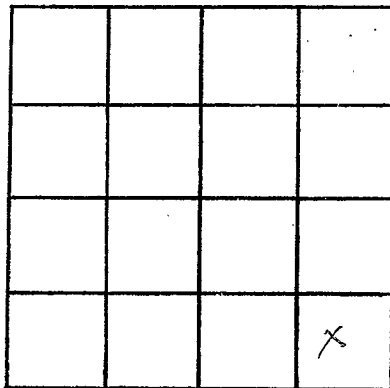

SECTION 35

Please indicate well location X.

ADDITIONAL INFORMATION

If more than one screen, show locations of each on sketch.