

LINCOLN
E 2006

MISSISSIPPI DEPARTMENT OF NATURAL RESOURCES
Bureau of Land and Water Resources
Southport Mall
P.O. Box 10631
Jackson, Mississippi 39209
WATER WELL DRILLERS LOG

May 29 1984 Grenn Water Well Lincoln
date well completed firm name county well located

LANDOWNER: Darrell White
Rt. 1, Box 276
Sontag, Ms.
(mailing address)

description of formations encountered

from	to
1	45
45	210
210	250

White Clay
Blue Clay
Sand

WELL LOCATION:

sec. 26 T 8 N R 9 E
S W
9 miles NE of Brookhaven
(distance) (direction) (nearest town)

WELL PURPOSE: home
(home, irrigation, municipal, industrial)

WELL COMPLETION DATA:

- diameter (inches) 4
- total depth (feet) 250
- static water level (feet) 160 below top of ground. above
- casing PVC 240'
(material) (depth)
4" if telescope see back.
(size)
- screen 10' 240'
(length) (depth to top)
.010 PVC
(size) (material)
- pump 1 sub 8
(HP) (yield gpm)
electricity
(type power)
- electric log no
(yes or no)
(organization running log)
- how well bottom plugged
back wash valve

DRILLERS REMARKS:


DEPT. OF NATURAL RESOURCES
BUREAU OF LAND & WATER RESOURCES

JUL 24 1984

RECEIVED

If well telescopes please sketch and show depths.

GROUND LEVEL

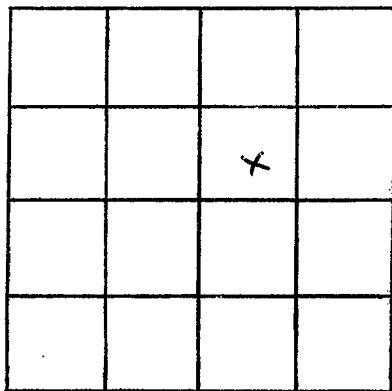

SECTION 26

Please indicate well location X.

ADDITIONAL INFORMATION

If more than one screen,
show locations of each on sketch.