

MISSISSIPPI DEPARTMENT OF NATURAL RESOURCES
Bureau of Land and Water Resources

P.O. Box 10631
Jackson, Mississippi 39209
WATER WELL DRILLERS LOG

COUNTY WELL LOCATED <i>Lincoln</i>	
WELL NUMBER <i>E 5</i>	CODED
DATE WELL COMPLETED <i>2012 4/6/90</i>	

PERMIT NUMBER
NAME OF DRILLING FIRM <i>Easley's Water Well</i> <i>Brookhaven, MS 39601</i>

NAME & MAILING ADDRESS OF LANDOWNER <i>Curtis Keays</i>
--

WELL LOCATION: SEC <i>2</i> TOWNSHIP <i>8</i> RANGE <i>9</i>
DIRECTION <i>W</i> NEAREST TOWN <i>Wesson</i>
DISTANCE <i>12</i> Miles

OTHER LANDMARK
WELL PURPOSE: Home, Irrigation, Municipal, Industrial, Fish Pond, etc. <i>Home</i>

PUMP DATA		
PUMP TYPE (Circle One): <u>Submersible</u> , Turbine, Jet, Flowing Well, Other (Describe) _____		
POWER TYPE (Circle One): Electric, Tractor, Diesel, Gasoline, Butane, Other (Describe) _____ H/P <u>1/2</u>		
Pump Capacity (GPM) <i>10</i>	No. of Stages <i>9</i>	Setting Depth <i>100</i> FT.
PUMP TEST		
Well yielded _____ GPM with a drawdown of _____ ft. after _____ hours of pumping		

WELL DATA		
Well Depth <i>130ft.</i>	Casing Diameter (In.) <i>4 in.</i>	Casing Length (Ft.) <i>120ft.</i>
Type of Casing <i>Pvc 40</i>	Hole Depth <i>130ft.</i>	Depth to Static Water Level
TYPE OF COMPLETION: (Circle One or More): <u>Natural Development</u> , Underreamed, Telescoped, Open Hole, Other		
Top of Lap Pipe or Reduction in Casing		
FEET IF TELESCOPED OR MORE THAN ONE SCREEN: USE BACK PAGE		


LOG DATA	
TYPE OF LOG RUN (Circle One): <u>Electric</u> , Gamma Ray, Density, Sonic, Neutron, Other (Describe) _____	
Name of Organization Running Log	

SCREEN DATA		
Diameter - Inches <i>4 in.</i>	Length - Feet <i>10 ft.</i>	Slot Size - Inches <i>0/10</i>
Screen Type <i>Pvc</i>	Depth to Bottom - Feet <i>130ft.</i>	

GEOLOGIC DATA (Office Use Only)			
Surface Elev.	Geologic Unit	Unit Thickness	Depth to Top
Subs. SWL	Date	Analysis	Aquifer Test

Driller's Remarks


DESCRIPTION OF FORMATIONS ENCOUNTERED	FROM	TO
<i>clay</i>	<i>0</i>	<i>40ft.</i>
<i>sand</i>	<i>40ft.</i>	<i>50ft.</i>
<i>clay</i>	<i>50ft.</i>	<i>110ft.</i>
<i>fine sand</i>	<i>110ft.</i>	<i>120ft.</i>
<i>coarse sand</i>	<i>120ft.</i>	<i>130ft.</i>

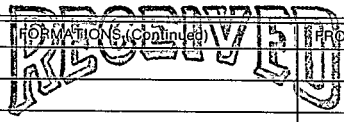

Department of Natural Resources Bureau of Land & Water Resources	
IF MORE SPACE IS NEEDED, USE BACK	

If well telescopes please
sketch and show depths.

GROUND LEVEL

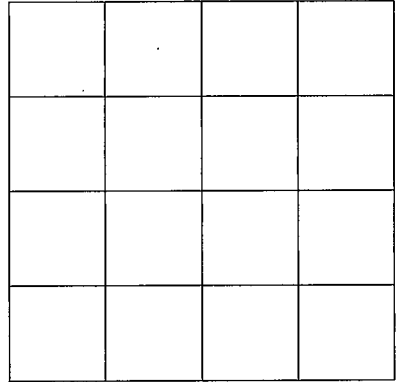

SECTION _____

Please indicate well location X.

ADDITIONAL INFORMATION

If more than one screen,
show location of each on sketch.