

MISSISSIPPI DEPARTMENT OF ENVIRONMENTAL QUALITY

Office of Land and Water Resources

P. O. Box 10631
Jackson, MS 39289-0631
WATER WELL DRILLERS LOG

COUNTY WELL LOCATED
Lincoln

WELL NUMBER
E-008

CODED

DATE WELL COMPLETED
9/17/02

PERMIT NUMBER

NAME OF DRILLING FIRM
Green Water Well & Supply, Inc.

NAME & MAILING ADDRESS OF LANDOWNER
David Allen

379 Woodworth Rd, Brookhaven

Latitude:

Longitude:

WELL LOCATION. SEC **35** TOWNSHIP **8 N** RANGE **9 E**

DISTANCE **12** Miles DIRECTION **NE** of NEAREST TOWN **Brookhaven**

OTHER LANDMARK

WELL PURPOSE: Home, Irrigation, Municipal, Industrial, Fish Pond, etc.

PUMP DATA

PUMP TYPE (Circle One):
 Submersible, Turbine, Jet, Flowing Well,
Other (Describe) _____

POWER TYPE (Circle One):
 Electric, Tractor, Diesel, Gasoline, Butane,
Other (Describe) _____ H/P **1**

DESCRIPTION OF FORMATIONS ENCOUNTERED	FROM	TO
streaky	0	55
white clay	55	107
blue clay	107	175
sand streaks	175	195
blue clay	195	300
streaky	300	330
sand	330	388

RECEIVED

OCT 07 2002

BY: OLWF

Top of Lap Pipe or Reduction in Casing

FEET IF TELESCOPED OR MORE THAN ONE SCREEN: USE BACK PAGE

WELL DATA

Well Depth 373'	Casing Diameter (In.) 4"	Casing Length (Ft.) 353'
Type of Casing PVC	Hole Depth 388'	Depth to Static Water Level 225'

TYPE OF COMPLETION: (Circle One or More):
 Gravel Packed, Underreamed, Telescoped,
 Natural Development, Open Hole, Other
(Describe) _____

WELL GROUTED TO A DEPTH OF **10** FEET
Type Grout (circle one): Cement, Bentonite, Mix

SCREEN DATA

Diameter - Inches 4"	Length - Feet 20'	Slot Size - Inches .010
Screen Type PVC	Depth to Bottom - Feet 373'	

I certify that the well was drilled, constructed and completed in accordance with all applicable Requirements of the Mississippi Department of Environmental Quality and/or the Mississippi Department of Health regulations and state laws.


Brian McClendon 664
0644
Signature of Licensed Driller and License No.

9/17/02
Date

Additional Information Required On Back

If well telescopes please sketch and show depths.

GROUND LEVEL

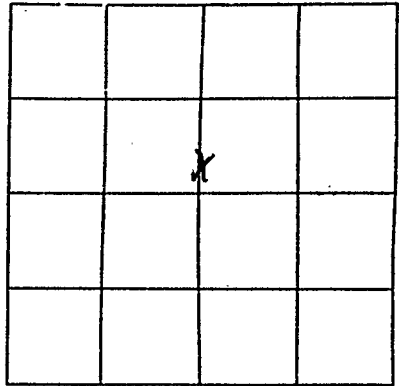

SECTION 35

Please indicate well location X.

Pump Capacity (GPM)	No. of Stages	Setting Depth
12	14	270 FT.

PUMP TEST

Well yielded 10 GPM with
 a drawdown of 15 ft.
 after 1 hours of pumping

LOG DATA

TYPE OF LOG RUN (Circle One): No Log Run
 Electric, Gamma Ray, Density, Sonic, Neutron,
 Other (Describe) _____

Name of Organization Running Log _____

GEOLOGIC DATA (Office Use Only)

Surface Elev.	Geologic Unit	Unit Thickness	Depth to Top
Subs. SWL	Date	Analysis	Aquifer Test

Driller's Remarks

Between 275' + 280'
circulated wood chips
up in drilling fluid.

If more than one screen,
 show location of each on sketch.