

LINCOLN  
F1

MISSISSIPPI BOARD OF WATER COMMISSIONERS

5-30-63 CODED WATER WELL DRILLERS LOG

Date: 5-30, 1963, Driller: Ed Jones County: Lincoln

(Name)

(1) Owner of Land:	Description & Color of Materials Sand, Clay, Red Clay, Shell, etc.	Thick- ness Feet	Depth Feet
(Name) <u>Jack R Smith</u> (Address) <u>Rt 3 Box 113 Brookhaven</u>	<u>Brown Clay</u> <u>Sand &amp; Gravel</u>	<u>0</u> <u>8</u>	<u>8</u> <u>70</u>
(2) Location: <u>NW 1/4, NW 1/4, Sec 12 T. 7 R. 6</u> <u>8</u> miles <u>West</u> of <u>Rhodes</u> (distance) (direction) (Nearest Town)			
(3) Topography: <u>Hilly</u> (Hilly) (Flat) (Level)			
(4) Purpose of Well: <u>Domestic</u> (Domestic Irrigation Municipal, Industrial, Other)			

Information upon completion of well:


- (1) Diameter 6" inches.
- (2) Total Depth 70' feet.
- (3) Water Level 37' feet below top of ground.
- (4) Cased to 70', Size 4"
- (5) Screen: Size 10, Length 6"
- (6) Were any formations sealed against pollution?  
 yes,  no.

If YES depth of formation \_\_\_\_\_

Why \_\_\_\_\_

Drillers Remarks: \_\_\_\_\_

CODED

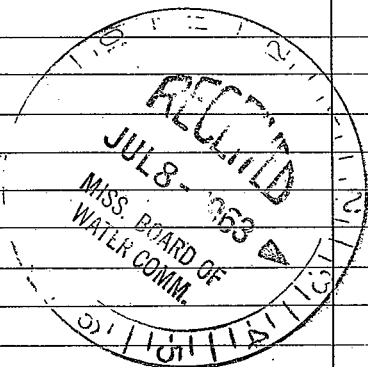

(Use Back Side)

Well No.

