

F2

1-7-65 CODED

WATER WELL DRILLERS LOG

Date: 1-7, 1965, Driller: Chester Keener County: Lincoln (Name)

(1) Owner of Land: Henschel Adam
 (Name)
A. R. Brookhaven
 (Address)

(2) Location: 1/4, 1/4 Sec. 13 T 7 R 6
8 miles west of Brookhaven
 (distance) (direction) (Nearest Town)

(3) Topography: Hilly
 (Hilly) (Flat) (Level)

(4) Purpose of Well: Domestic
 (Domestic Irrigation, Municipal, Industrial, Other)

Description & Color of Materials Sand, Clay, Red Clay, Shell, etc.	Thick- ness Feet	Depth Feet
<u>Red Clay</u>	<u>20</u>	<u>20</u>
<u>Sand & gravel</u>	<u>38</u>	<u>58</u>
<u>Light yellow</u>	<u>7</u>	<u>65</u>
<u>Sand & gravel</u>	<u>18</u>	<u>83</u>

CODED

Information upon completion of well:

(1) Diameter 4 inches.

(2) Total Depth 123 feet.

(3) Water Level 75 feet below top of ground.


(4) Cased to bottom size 4"

(5) Screen: Size 4", Length 7'

(6) Were any formations sealed against pollution?
 ___ yes, X no.

If YES depth of formation _____
 Why _____

Drillers Remarks: New Home

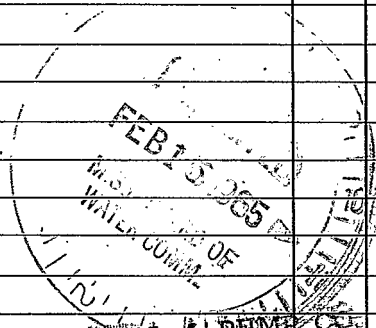

REEVES WELL & DRILL CO.
 P. O. BOX 71 -- PHONE 684-1451
 McCOMB, MISS.

(Use Back Side)

Well No.

