

Lincoln

CODED

F3

3-67

MISSISSIPPI  
 BOARD OF WATER COMMISSIONERS  
 416 North State Street  
 Jackson, Mississippi 39201

WATER WELL DRILLERS LOG

3-28

date well completed

69 Fitzgerald W W Service Lincoln

firm name

county well located

LANDOWNER: J G Smith

Rt 3 Bull Brookhaven

(mailing address)

description of formations encountered

from to

Red gravel	0	16
Sand	16	40
Chalk	40	186
Sand	186	195
Chalk	195	228
Sand & gravel	228	274
Chalk	274	

WELL LOCATION:

sec. 3 T. 7 N. R. 6 E  
 S W  
 10 miles W - 4 miles S of Brookhaven  
 (distance) (direction) (nearest town)

WELL PURPOSE: Home (home, irrigation, municipal, industrial)

WELL COMPLETION DATA:


- (1) diameter (inches) 4 3/4
- (2) total depth (feet) 274
- (3) static water level (feet) 80 below top of ground.
- (4) casing plastic 266 (material) (depth)
- (size) 4 If telescope see back.
- (5) screen 81 266 (length) (depth to top)
- (size) 4 plastic (material)
- (6) pump sub 15 (HP) (yield gpm)
- (type power) elec
- (7) electric log 410 (yes or no)

(organization running log)

(8) how well bottom plugged Wood peg


DRILLERS REMARKS:

CODED

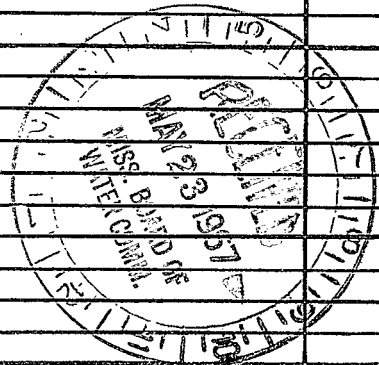

If well telescopes please sketch and show depths.

GROUND LEVEL

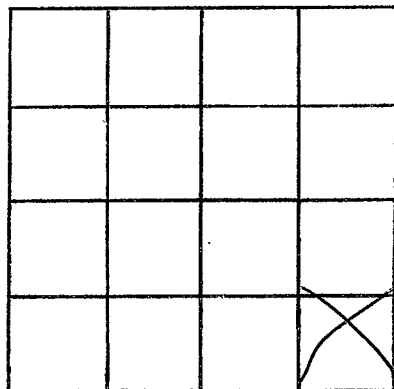

SECTION 3

Please indicate well location X.

ADDITIONAL INFORMATION

Lined area for additional information, consisting of approximately 20 horizontal lines.

If more than one screen, show locations of each on sketch.