

MISSISSIPPI
BOARD OF WATER COMMISSIONERS
416 North State Street
Jackson, Mississippi 39201

WATER WELL DRILLERS LOG

Lincoln
74
10-67 CODED

10-20
date well completed

1967 Fitzgerald W/W. Lincoln
firm name county well located

LANDOWNER: AW Smith

description of formations
encountered

from to

RT5 BK152

Brookhaven Miss
(mailing address)

| | | |
|----------------------|-----|-----|
| Top Soil + clay | 0 | 2 |
| Sand | 4 | 38 |
| White Chalk | 38 | 86 |
| Fine Sand | 86 | 114 |
| Coarse Sand + gravel | 114 | 150 |

WELL LOCATION:

27 T N R 6 E
S W
9 miles West SW of Brookhaven
(distance) (direction) (nearest town)

Yellow Chalk 150

WELL PURPOSE:

(home, irrigation, municipal, industrial)

WELL COMPLETION DATA:


- (1) diameter (inches) 4
- (2) total depth (feet) 150
- (3) static water level (feet) 90 below/above top of ground.
- (4) casing plastic 114
(material) (depth)
- 4 if telescope see back.
(size)
- (5) screen 6' 114
(length) (depth to top)
- 4 plastic
(size) (material)
- (6) pump — —
(HP) (yield gpm)
- Elec
(type power)
- (7) electric log NO
(yes of no)

CODED

(organization running log)


(8) how well bottom plugged Weld peg

DRILLERS REMARKS:

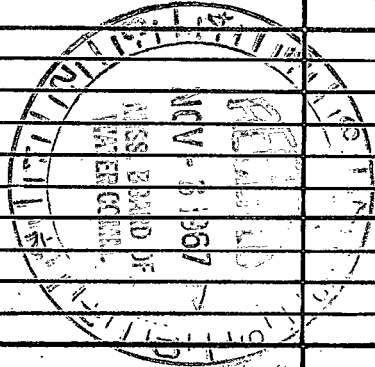

If well telescopes please sketch and show depths.

GROUND LEVEL

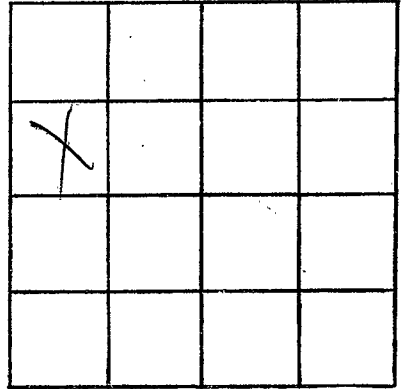

SECTION 29

Please indicate well location X.

ADDITIONAL INFORMATION

If more than one screen,
show locations of each on sketch.