

CODED

MISSISSIPPI BOARD OF WATER COMMISSIONERS
416 North State Street
Jackson, Mississippi 39201

WATER WELL DRILLERS LOG

Lincoln
77
9-19-68

9-19- 1968 Fitzgerald well serv Lincoln
date well completed firm name county well located

LANDOWNER:
Richard Calcutt
RR. Brookhaven Miss.
(mailing address)


description of formations encountered	from	to
<u>red clay</u>	<u>0</u>	<u>20</u>
<u>fine sand</u>	<u>20</u>	<u>80</u>
<u>white clay</u>	<u>80</u>	<u>105</u>
<u>loose sand & gravel</u>	<u>105</u>	<u>115</u>

WELL LOCATION:
sec. 22 T. 7 N R. 6 E
S W
12 miles W of Brookhaven
(distance) (direction) (nearest town)

WELL PURPOSE:
(home, irrigation, municipal, industrial)

WELL COMPLETION DATA:


- (1) diameter (inches) 4
- (2) total depth (feet) 115
- (3) static water level (feet) 70 below above top of ground.
- (4) casing Plastic, 109,
(material) (depth)
4 if telescope see back.
(size)
- (5) screen 6, 109
(length) (depth to top)
4, plastic
(size) (material)
- (6) pump ?, ?
(HP) (yield gpm)
elm
(type power)
- (7) electric log no
(yes or no)
(organization running log)
- (8) how well bottom plugged wood peg

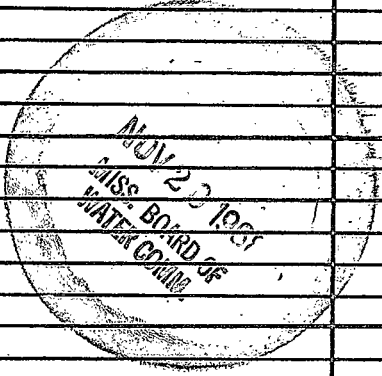

DRILLERS REMARKS:

If well telescopes please sketch and show depths.

GROUND LEVEL

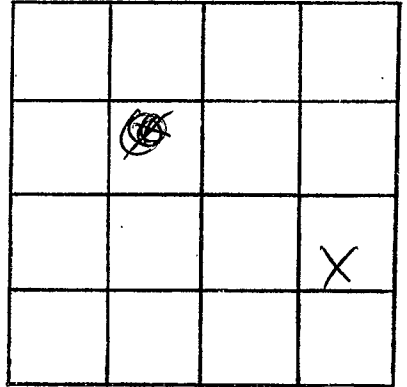

SECTION 22

Please indicate well location X.

ADDITIONAL INFORMATION

If more than one screen,
show locations of each on sketch.