

CODE

MISSISSIPPI
BOARD OF WATER COMMISSIONERS
416 North State Street
Jackson, Mississippi 39201

WATER WELL DRILLERS LOG

Lincoln Co
F 8
2-25-70

Feb. 25, 1970 1970 Green Water Well Contractor Lincoln
date well completed firm name county well located

LANDOWNER: Mrs. P.H. Carpenter	description of formations encountered	from	to
	Citronelle	0	93
(mailing address)			
WELL LOCATION: sec. 14 T 7 R 8 E S. E. 8 miles west of Brookhaven (distance) (direction) (nearest town)			
WELL PURPOSE: home (home, irrigation, municipal, industrial)			
WELL COMPLETION DATA:			
(1) diameter (inches) 6 in.			
(2) total depth (feet) 93 ft.			
(3) static water level (feet) _____ below above top of ground.			
(4) casing PVC 93 (material) (depth) (size) if telescope see back.			
(5) screen 4 ft. 89 ft. (length) (depth to top) .014 PVC (size) (material)			
(6) pump did not install (HP) (yield gpm) (type power)			
(7) electric log no (yes or no)			
(organization running log)			
(8) how well bottom plugged wood			
DRILLERS REMARKS:			


CODE

MAR 27 1970

MISS. BD. OF
WATER COMM.

If well telescopes please sketch and show depths.

GROUND LEVEL

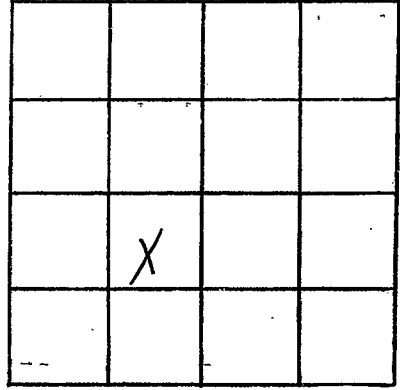

SECTION 14

Please indicate well location X.

ADDITIONAL INFORMATION

If more than one screen, show locations of each on sketch.