

MISSISSIPPI
BOARD OF WATER COMMISSIONERS
416 North State Street
Jackson, Mississippi 39201

CODED

WATER WELL DRILLERS LOG

LINCOLN
F9
11-13-70

11-13 date well completed 1970 *Fitzgerald* firm name Lincoln county well located

LANDOWNER:
Ray Hollingsworth
R.R. Brookman
(mailing address)

description of formations encountered	from	to
<i>Red clay</i>	<i>0</i>	<i>20</i>
<i>Red sand</i>	<i>20</i>	<i>75</i>
<i>Coarse sand & gravel</i>	<i>75</i>	<i>95</i>

WELL LOCATION:
sec. 36 T. 7 S. R. 6E
5 miles WN of Brookman
(distance) (direction) (nearest town)

WELL PURPOSE: *Home*
(home, irrigation, municipal, industrial)

CODED

- WELL COMPLETION DATA:
- (1) diameter (inches) 4
 - (2) total depth (feet) 95
 - (3) static water level (feet) 55 below top of ground.
 - (4) casing plastic, 87 (material) (depth)
7 (size) if telescope see back.
 - (5) screen 8, 87 (length) (depth to top)
4 (size) plastic (material)
 - (6) pump 3/4, 6 (HP) (yield gpm)
elm (type power)
 - (7) electric log yes (yes or no)
(organization running log)
 - (8) how well bottom plugged completely


DRILLERS REMARKS:

NOV 18 1970

MISSISSIPPI BOARD OF WATER COMMISSIONERS

If well telescopes please sketch and show depths.

GROUND LEVEL

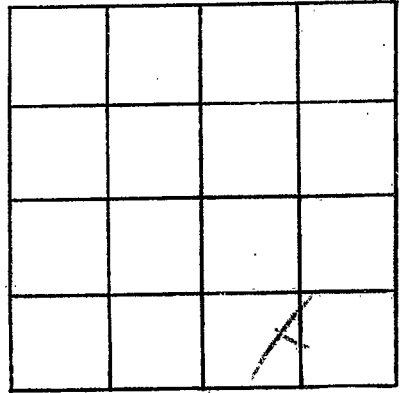

SECTION 36

Please indicate well location X.

ADDITIONAL INFORMATION

If more than one screen,
show locations of each on sketch.