

Lincoln
F12
1-26-73

MISSISSIPPI
BOARD OF WATER COMMISSIONERS
416 North State Street
Jackson, Mississippi 39201

CODED

WATER WELL DRILLERS LOG

Jan 26 1973 Chester Reeves Lincoln
 Core well completed firm name county well located

LANDOWNER: Willard D. Smith
Rt 2 Brookhaven
 (mailing address)

WELL LOCATION:
 sec 13 T 7 N R 6 E
6 1/2 miles W Brookhaven
 (distance) (direction) (nearest town)

WELL PURPOSE: House
 (home, irrigation, municipal, industrial)

WELL COMPLETION DATA:

(1) diameter (inches) 4"

(2) total depth (feet) 115

(3) static water level (feet) 52 below above top of ground.

(4) casing Plast bottom
 (material) (depth)

_____ if telescope see back.
 (size)

(5) screen 6' 109
 (length) (depth to top)

4" Plast
 (size) (material)

(6) pump Byouner
 (HP) (yield gpm)

_____ (type power)

(7) electric log no
 (yes or no)

_____ (organization running log)

description of formations encountered	from	to
Red Sandy Clay	0	16
Red Sand	16	58
Sand & gravel	58	71
White chalk	71	104
Coarse sand	104	115

CODED


(8) how well bottom plugged
wooden plug

DRILLERS REMARKS:
New house

REC-6 1072
 MISSISSIPPI BOARD OF WATER COMMISSIONERS

If well telescopes please sketch and show depths.

GROUND LEVEL

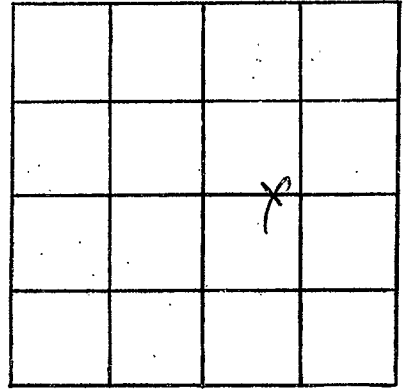

SECTION 13

Please indicate well location X.

ADDITIONAL INFORMATION

If more than one screen,
show locations of each on sketch.