

LINCOLN
 F 13
 7-23-73

MISSISSIPPI
 BOARD OF WATER COMMISSIONERS
 416 North State Street
 Jackson, Mississippi 39201.

CODED

WATER WELL DRILLERS LOG

72 April 1973 J.T. Crayton Lincoln
 date well completed firm name county well located

LANDOWNER:

H. C. Smith
 Brookhaven Miss.
 (mailing address)

description of formations encountered

from to

Clay	0	15
Clay shale	05	45
Sand	45	55
Sand chert	55	65
Sand	65	85

WELL LOCATION:

sec. 35 T 7 N R. 6 E
 0 miles W of Brookhaven
 (distance) (direction) (nearest town)

WELL PURPOSE:

(home, irrigation, municipal, industrial)

WELL COMPLETION DATA:

- (1) diameter (inches) 4
- (2) total depth (feet) 85
- (3) static water level (feet) 65 below top of ground.
- (4) casing 1" 79
 (material) (depth)
 (size) if telescope see back.
- (5) screen 1" 29
 (length) (depth to top)
 1" 1"
 (size) (material)
- (6) pump 1/2 8
 (HP) (yield gpm)
 1/2
 (type power)
- (7) electric log _____
 (yes or no)

 (organization running log)
- (8) how well bottom plugged Wood


CODED

DRILLERS REMARKS:

JUL 17 1973

If well telescopes please sketch and show depths.

GROUND LEVEL

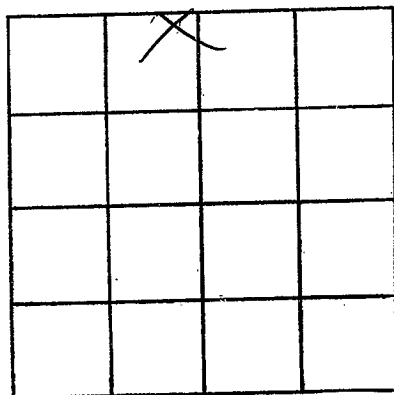

SECTION 35

Please indicate well location X.

ADDITIONAL INFORMATION

If more than one screen, show locations of each on sketch.