

LINCOLN
F 14
9-73

MISSISSIPPI
BOARD OF WATER COMMISSIONERS [CODED]
416 North State Street
Jackson, Mississippi 39201
WATER WELL DRILLERS LOG

date well completed: 19 Green water well contracts firm name: Lincoln county well located: Lincoln

LANDOWNER: Frank Jacobs
12111 white oak
Houston, Tex. 77035
(mailing address)

description of formations encountered	from	to
<u>Citronelle</u>	<u>0</u>	<u>90</u>

WELL LOCATION:
sec. 13 T. 7 N. R. 6 E
6 miles W of Brookhaven
(distance) (direction) (nearest town)

WELL PURPOSE: Home
(home, irrigation, municipal, industrial)

WELL COMPLETION DATA:

(1) diameter (inches) 6"

(2) total depth (feet) 70

(3) static water level (feet) 49 below above top of ground.

(4) casing PVC, 64,
(material) (depth)
4" if telescope see back.
(size)

(5) screen 6', 64
(length) (depth to top)
2 1/2, PVC
(size) (material)

(6) pump 1/3 Sub, 7
(HP) (yield gpm)
electricity
(type power)

(7) electric log no
(yes or no)

(organization running log)

(8) how well bottom plugged wood

CODED


OCT 25 1973

DRILLERS REMARKS:

MISSISSIPPI BOARD OF WATER COMMISSIONERS

If well telescopes please sketch and show depths.

GROUND LEVEL

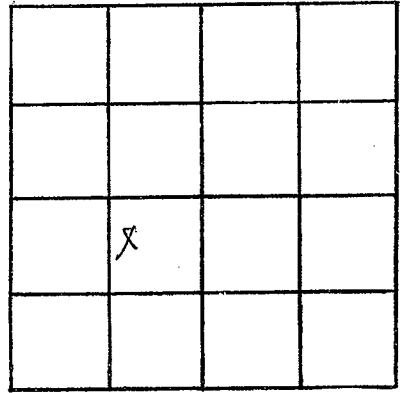

SECTION 13

Please indicate well location X.

ADDITIONAL INFORMATION

If more than one screen,
show locations of each on sketch.