

LINCOLN
F 19
9-12-73

MISSISSIPPI
BOARD OF WATER COMMISSIONERS
416 North State Street
Jackson, Mississippi 39201

CODED

WATER WELL DRILLERS LOG

Sept 12 1973 Chester Keene Lincoln
date well completed firm name county well located

LANDOWNER: Edward Falvey
RFD Brookhaven
(mailing address)

WELL LOCATION:
sec. 13 T. 7 N. R. 6 E.
6 1/2 miles W of Brookhaven
(distance) (direction) (nearest town)

WELL PURPOSE: House
(home, irrigation, municipal, industrial)

- WELL COMPLETION DATA:
- (1) diameter (inches) 4"
 - (2) total depth (feet) 95
 - (3) static water level (feet) 20 below top of ground.
 - (4) casing Plast, balcon
(material) (depth)
 - _____ if telescope see back.
(size)
 - (5) screen 6', 89'
(length) (depth to top)
 - 4", Plast
(size) (material)
 - (6) pump Galley's
(HP) (yield gpm)
 - _____ (type power)
 - (7) electric log no
(yes or no)
 - _____ (organization running log)
 - (8) how well bottom plugged wood plug

description of formations encountered	from	to
clay	0	14
Sand & gravel	14	20
white chalk	20	62
fine sand	62	86
coarse sand	86	95

CODED


DRILLERS REMARKS:
New house.

RECEIVED
MAY 30 1974

MISS. BD. OF WATER COMMISSIONERS

If well telescopes please sketch and show depths.

GROUND LEVEL

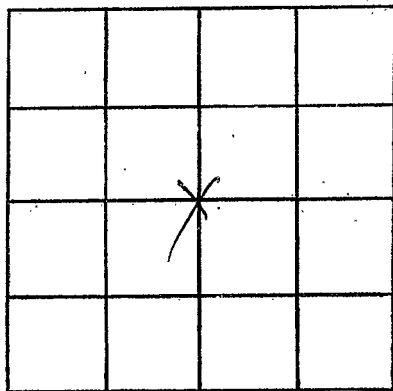

SECTION 13

Please indicate well location X.

ADDITIONAL INFORMATION

If more than one screen,
show locations of each on sketch.