

MISSISSIPPI DEPARTMENT OF NATURAL RESOURCES

Bureau of Land and Water Resources

Southport Mall

P.O. Box 10631

Jackson, Mississippi 39209

WATER WELL DRILLERS LOG

CODED

LINCOLN  
K-40 F 43

Oct. 24 19 84 Gretn Water Well Lincoln  
date well completed firm name county well located

LANDOWNER: Howard Case

Rt. 2, Box 463

Brookhaven, Ms.

(mailing address)

description of formations encountered  
Citronelle

from  
1

746  
140

CODED

WELL LOCATION:

sec. 24 7 N S R 6 E W

5 miles W of Brookhaven  
(distance) (direction) (nearest town)

WELL PURPOSE: home  
(home, irrigation, municipal, industrial)

WELL COMPLETION DATA:

- (1) diameter (inches) 4
- (2) total depth (feet) 146
- (3) static water level (feet) 80 below above top of ground.
- (4) casing PVC 136  
(material) (depth)  
4" if telescope see back.  
(size)
- (5) screen 10' 136'  
(length) (depth to top)  
.010 PVC  
(size) (material)
- (6) pump 1/2 sub 10  
(HP) (yield gpm)  
electricity  
(type power)
- (7) electric log no  
(yes or no)

(organization running log)

(8) how well bottom plugged  
back wash valve


RECEIVED  
APR 17 1985

DRILLERS REMARKS:

Department of Natural Resources  
Bureau of Land & Water Resources

If well telescopes please sketch and show depths.

GROUND LEVEL

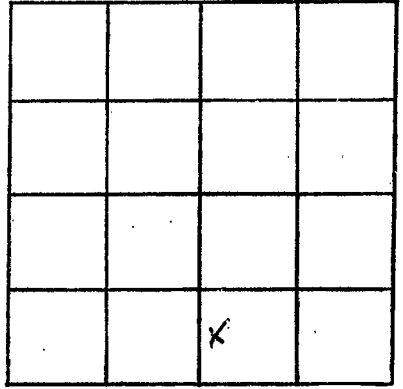

SECTION 24

Please indicate well location X.

ADDITIONAL INFORMATION

If more than one screen,  
show locations of each on sketch.