

LINCOLN
F 45

MISSISSIPPI
BOARD OF WATER COMMISSIONERS CODED
416 North State Street
Jackson, Mississippi 39201


WATER WELL DRILLERS LOG

12-5-1985 Tom Griffith Well Service Lincoln
date well completed firm name county well located

LANDOWNER: <u>David + New</u> <u>P.O. Box 1487</u> <u>Natchez, MS</u> (mailing address)	description of formations encountered	from	to
WELL LOCATION: sec <u>23</u> T <u>7</u> <u>N</u> R <u>6</u> <u>E</u> <u>7</u> miles <u>w</u> of <u>Brookhaven</u> (distance) (direction) (nearest town)	<u>Red Sand</u> <u>Gravel</u> <u>Clay</u> <u>Sand</u>	<u>1</u> <u>10</u> <u>110</u> <u>340</u>	<u>10</u> <u>110</u> <u>340</u> <u>410</u>
WELL PURPOSE: <u>Oil Location</u> (home, irrigation, municipal, industrial)	CODED		
WELL COMPLETION DATA: (1) diameter (inches) <u>3"</u> (2) total depth (feet) <u>410'</u> (3) static water level (feet) <u>120</u> <u>below</u> top of ground. (4) casing <u>PVC</u> , <u>370'</u> , (material) (depth) <u>NA</u> if telescope see back. (size) (5) screen <u>40'</u> , <u>370'</u> (length) (depth to top) <u>3"</u> , <u>PVC</u> (size) (material) (6) pump <u>Air Lift</u> <u>125</u> (HP) (yield gpm) <u>diel</u> (type power) (7) electric log <u>NO</u> (yes or no) <u>NA</u> (organization running log) (8) how well bottom plugged <u>BWV</u>			
DRILLERS REMARKS:	DIRECTOR FEB 7 1986	Department of Natural Resources Bureau of Land & Water	

If well telescopes please sketch and show depths.

GROUND LEVEL

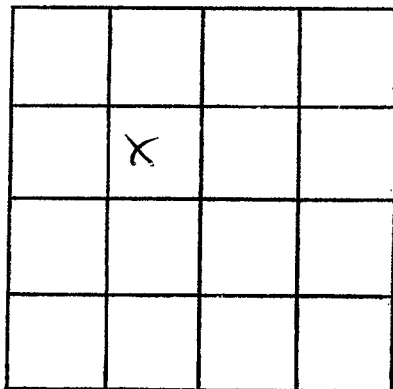

SECTION _____

Please indicate well location X.

ADDITIONAL INFORMATION

If more than one screen,
show locations of each on sketch.