

LINCOLN
F 47
5/31/77

MISSISSIPPI
 BOARD OF WATER COMMISSIONERS
 416 North State Street
 Jackson, Mississippi 39201

14A

WATER WELL DRILLERS LOG

May 31 1977 Grenn Water Well Cont. Lincoln
 date well completed firm name county well located

LANDOWNER: Tommy Nettles
Route 5, Box 257
Brookhaven, Miss.
 (mailing address)

description of formations encountered	from	to
clay	1	30
sand & gravel	30	58
white clay	58	68
blue clay	68	100
sand	100	151

WELL LOCATION:
 SW NE sec. 25 T. 7 N R. 2 E
 S W
 7 miles W of Brookhaven
 (distance) (direction) (nearest town)

WELL PURPOSE: home
 (home, irrigation, municipal, industrial)

WELL COMPLETION DATA:

(1) diameter (inches) 6

(2) total depth (feet) 151

(3) static water level (feet) 75 below top of ground.

(4) casing PVC 145
 (material) (depth)
4"
 (size) if telescope see back.

(5) screen 6" 145'
 (length) (depth to top)
.010 PVC
 (size) (material)

(6) pump did not install
 (HP) (yield gpm)

(type power)

(7) electric log no
 (yes or no)

(organization running log)

(8) how well bottom plugged back wash valve


RECEIVED

AUG 24 1977

DRILLERS REMARKS:

If well telescopes please sketch and show depths.

GROUND LEVEL

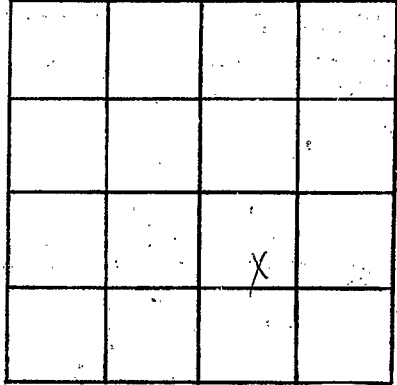

SECTION 25

Please indicate well location X.

ADDITIONAL INFORMATION

A series of horizontal lines for writing additional information.

If more than one screen, show locations of each on sketch.