

Lincoln
 F 2000
 5/8/77

14A

MISSISSIPPI
 BOARD OF WATER COMMISSIONERS
 416 North State Street
 Jackson, Mississippi 39201

WATER WELL DRILLERS LOG

May 8 1977 Grenn Water Well Cont. Lincoln
 date well completed firm name county well located


LANDOWNER:	description of formations encountered	from	to
Billy P. Smith Route 2, Box 39 Brookhaven, Miss. (mailing address)	Citronelle	1	80
WELL LOCATION: sec. 23 T. 7 <u>N</u> R. 6 <u>E</u> 7 miles W of Brookhaven (distance) (direction) (nearest town)			
WELL PURPOSE: home (home, irrigation, municipal, industrial)			
WELL COMPLETION DATA: (1) diameter (inches) 6 (2) total depth (feet) 80 (3) static water level (feet) 50 below top of ground. (4) casing PVC 74 (material) (depth) 4" (size) If telescope see back. (5) screen 6' 74' (length) (depth to top) .010 PVC (size) (material) (6) pump 1/2 sub 10 (HP) (yield gpm) electricity (type power) (7) electric log no (yes or no) (organization running log) (8) how well bottom plugged back wash valve			
DRILLERS REMARKS:			

RECEIVED
 JUN 14 1977

MISS. BD. OF WATER COMMISSIONERS

If well telescopes please sketch and show depths.

GROUND LEVEL

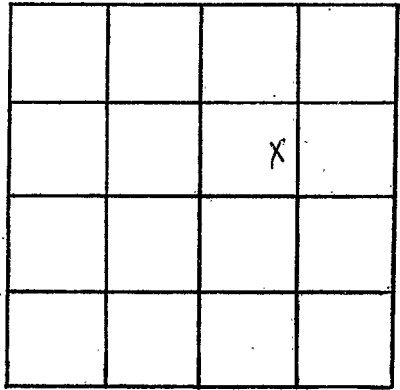

SECTION 23

Please indicate well location X.

ADDITIONAL INFORMATION

If more than one screen,
show locations of each on sketch.