

Lincoln  
 F 2001  
 June 3, 1977

MISSISSIPPI  
 BOARD OF WATER COMMISSIONERS  
 416 North State Street  
 Jackson, Mississippi 39201

WATER WELL DRILLERS LOG

June 3 1977 Grenn Water Well Cont. Lincoln  
 date well completed firm name county well located

LANDOWNER:	description of fomations encountered	from	to
Layton Case Route 2, Brookhaven, Miss.	Citronelle	1	96

(mailing address)

WELL LOCATION:

sec. 13 T 7 N R 6 E  
 S W  
 5 miles W of Brookhaven  
 (distance) (direction) (nearest town)

WELL PURPOSE: none  
 (home, irrigation, municipal, industrial)

WELL COMPLETION DATA:

- (1) diameter (inches) 6
- (2) total depth (feet) 96
- (3) static water level (feet) 40 below top of ground.
- (4) casing PVC 90' (material) (depth)  
 4" (size) If telescope see back.
- (5) screen 6' 90' (length) (depth to top)  
 .010 PVC (size) (material)
- (6) pump 1/3 hp sub. 101 (HP) (yield gpm)  
 electricity (type power)
- (7) electric log no (yes or no)

(organization running log)

(8) how well bottom plugged back wash valve


DRILLERS REMARKS:

RECEIVED  
 AUG 24 1977

MISS. DD. OF WATER COMMISSIONERS

If well telescopes please sketch and show depths.

GROUND LEVEL

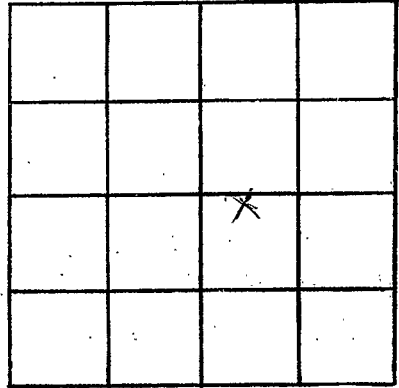

SECTION 13

Please indicate well location X.

ADDITIONAL INFORMATION

If more than one screen, show locations of each on sketch.