

LINCOLN
E 2002
7-25-77

MISSISSIPPI
BOARD OF WATER COMMISSIONERS
416 North State Street
1321 Jackson, Mississippi 39201

WATER WELL DRILLERS LOG

July 25 19 77 Grenn Water Well Cont. Lincoln
date well completed firm name county well located

LANDOWNER: Steve Case
Route 5
Brookhaven, Miss.
(mailing address)

description of fomations encountered	from	to
	citronelle	1

WELL LOCATION:
sec. 36 T 7 N R 6 E
S W
5 miles W of Brookhaven
(distance) (direction) (nearest town)

WELL PURPOSE: home
(home, irrigation, municipal, industrial)

- WELL COMPLETION DATA:
- (1) diameter (inches) 6
 - (2) total depth (feet) 93
 - (3) static water level (feet) 35 below top of ground.
 - (4) casing PVC 81 (material), (depth)
4" (size) if telescope see back.
 - (5) screen 12' 81' (length), (depth to top)
.010 PVC (size) (material)
 - (6) pump did not install (HP) (yield gpm)
 - (type power)
 - (7) electric log no (yes or no)
 - (organization running log)
 - (8) how well bottom plugged back wash valve


DRILLERS REMARKS:

RECEIVED
AUG 24 1977

MISS. BD. OF WATER COMM

If well telescopes please sketch and show depths.

GROUND LEVEL

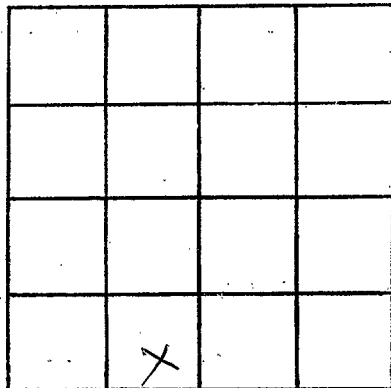

SECTION 36

Please indicate well location X.

ADDITIONAL INFORMATION

If more than one screen, show locations of each on sketch.