

LINCOLN
F
2004

**MISSISSIPPI
BOARD OF WATER COMMISSIONERS**
416 North State Street
Jackson, Mississippi 39201

WATER WELL DRILLERS LOG


Jan 17 1978 Brunswick Lincoln
 date well completed firm name county well located

LANDOWNER:	description of formations encountered	from	to
<u>Curtis Green</u> <u>At 6 Brookhaven</u> (mailing address)			
WELL LOCATION:			
sec. <u>13</u> T <u>7</u> N R <u>6</u> E			
<u>2</u> miles <u>(West)</u> of <u>Zetun</u> (distance) (direction) (nearest town)			
WELL PURPOSE: <u>Domestic</u> (home, irrigation, municipal, industrial)			
WELL COMPLETION DATA:			
(1) diameter (inches) <u>4"</u>			
(2) total depth (feet) <u>111</u>			
(3) static water level (feet) <u>76</u> below above top of ground.			
(4) casing <u>plastic bottom</u> (material) (depth)			
<input checked="" type="checkbox"/> if telescope see back. (size)			
(5) screen <u>5'</u> <u>106'</u> (length) (depth to top)			
<u>4"</u> <u>plastic</u> (size) (material)			
(6) pump <u>Leathur</u> (HP) (yield gpm)			
<u>elect</u> (type power)			
(7) electric log <u>no</u> (yes or no)			
(organization running log)			
(8) how well bottom plugged <u>Wooder Plug</u>			
DRILLERS REMARKS:			

RECEIVED
MAY 11 1978

If well telescopes please sketch and show depths.

GROUND LEVEL

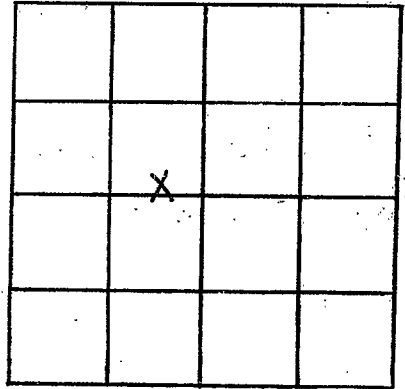

SECTION 13

Please indicate well location X.

ADDITIONAL INFORMATION

If more than one screen,
show locations of each on sketch.