

LINCOLN
 F 2005
 2/14/78

MISSISSIPPI
 BOARD OF WATER COMMISSIONERS
 416 North State Street
 Jackson, Mississippi 39201

WATER WELL DRILLERS LOG

Feb. 14, 1978 Grenn Water Well Cont. Lincoln

date well completed firm name county well located

LANDOWNER: Roger Smith
 Route 5, Box 267
 Brookhaven, Miss.
 (mailing address)

description of formations encountered	from	to
Clay	1	25
sand & gravel	25	80
clay	80	110
sand	110	161

WELL LOCATION:
 sec. 25 T. 7 N R. 6 E
 S W
 6 miles W of Brookhaven
 (distance) (direction) (nearest town)

WELL PURPOSE: home
 (home, irrigation, municipal, industrial)

WELL COMPLETION DATA:

- (1) diameter (inches) 6
- (2) total depth (feet) 161
- (3) static water level (feet) 70 below top of ground.
- (4) casing PVC, 155' (material) (depth)
 4" (size) If telescope see back.
- (5) screen 6" length, 155' (depth to top)
 .010 PVC (size) (material)
- (6) pump did not install (HP) (yield gpm)
 (type power)
- (7) electric log: no (yes or no)
 (organization running log)
- (8) how well bottom plugged backwash valve


DRILLERS REMARKS:

RECEIVED
 FEB 27 1978

MISS. BD. OF WATER COMM

If well telescopes please sketch and show depths.

GROUND LEVEL

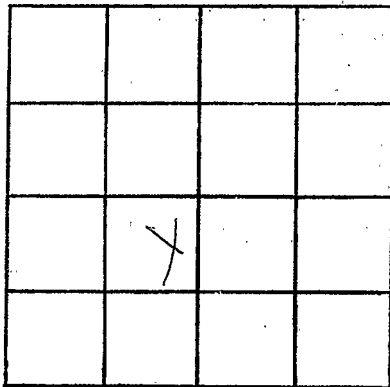

SECTION 6

Please indicate well location X.

ADDITIONAL INFORMATION

If more than one screen,
show locations of each on sketch.