

LINCOLN  
F 2006  
2/17/78

MISSISSIPPI  
 BOARD OF WATER COMMISSIONERS  
 416 North State Street  
 Jackson, Mississippi 39201

WATER WELL DRILLERS LOG

Feb. 17, 1978 Grenn Water Well Cont.

Lincoln

date well completed

firm name

county well located


LANDOWNER: <u>Prentiss Smith</u> <u>Route 2, Box 1205</u> <u>Brookhaven, Miss.</u> (mailing address)	description of formations encountered <u>Citronelle</u>	from	to
<b>WELL LOCATION:</b>			
sec. <u>13</u> T. <u>7</u> (N) R. <u>6</u> (E) S W <u>5</u> miles <u>W</u> of <u>Brookhaven</u> (distance) (direction) (nearest town)			
<b>WELL PURPOSE:</b> <u>home</u> (home, irrigation, municipal, industrial)			
<b>WELL COMPLETION DATA:</b>			
(1) diameter (inches) <u>6</u>			
(2) total depth (feet) <u>86</u>			
(3) static water level (feet) <u>66</u> below top of ground.			
(4) casing <u>PVC</u> <u>74</u> (material) (depth) <u>4"</u> if telescope see back. (size)			
(5) screen <u>12'</u> <u>74'</u> (length) (depth to top) <u>.010</u> <u>PVC</u> (size) (material)			
(6) pump <u>did not install</u> (HP) (yield gpm)  (type power)			
(7) electric log <u>no</u> (yes or no)  (organization running log)			
(8) how well bottom plugged <u>backwash valve</u>			
DRILLERS REMARKS:			

RECEIVED  
 FEB 27 1978

RD. OF WATER COMM

If well telescopes please sketch and show depths.

GROUND LEVEL

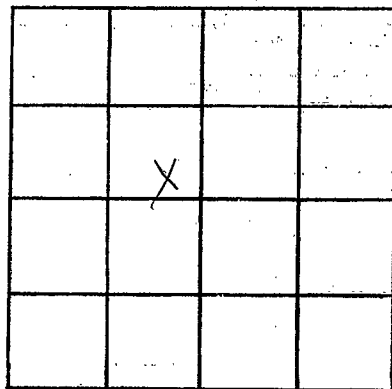

SECTION 13

Please indicate well location X.

ADDITIONAL INFORMATION

If more than one screen, show locations of each on sketch.