

LINCOLN  
F  
03-16-79  
2010

MISSISSIPPI  
BOARD OF WATER COMMISSIONERS  
416 North State Street  
Jackson, Mississippi 39201

WATER WELL DRILLERS LOG

March 16 1979 Grenn Water Well Lincoln  
date well completed firm name county well located

LANDOWNER: Gary Green  
Route 5  
Brookhasven, Miss.  
(mailing address)

description of formations encountered  
Citronelle  
from 1 to 117

WELL LOCATION:  
sec 15 T 7 N R 6 E  
9 miles W Brookhasven  
(distance) (direction) (nearest town)

WELL PURPOSE: home  
(home, irrigation, municipal, industrial)

WELL COMPLETION DATA:  
(1) diameter (inches) 4  
(2) total depth (feet) 117  
(3) static water level (feet) 90 below above top of ground.  
(4) casing PVC 105' (material) (depth)  
4" (size) if telescope see back.  
(5) screen 12' 105' (length) (depth to top)  
.010 PVC (size) (material)  
(6) pump 3/4 sub 10 (HP) (yield gpm)  
electricity (type power)  
(7) electric log no (yes or no)  
(organization running log)


(8) how well bottom plugged backwash valve

DRILLERS REMARKS:

Miss. Board of Water Comm.  
MAY 9 1979  
RECEIVED

If well telescopes please sketch and show depths.

GROUND LEVEL

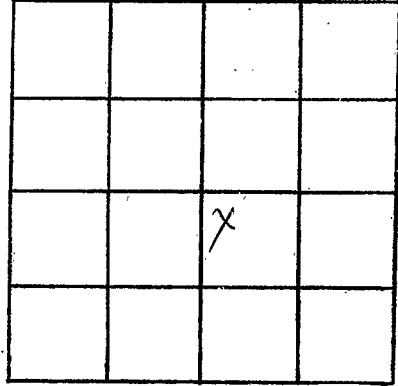

SECTION 15

Please indicate well location X.

ADDITIONAL INFORMATION

If more than one screen,  
show locations of each on sketch.