

Lincoln
F 2011
5-25-79

MISSISSIPPI
 BOARD OF WATER COMMISSIONERS
 416 North State Street
 Jackson, Mississippi 39201

WATER WELL DRILLERS LOG

May 25 1979 Grenn Water Well Cont. Lincoln
 date well completed firm name county well located

LANDOWNER: <u>John Calcote</u>	description of formations encountered	from	to
Route <u>3</u> , Box <u>174</u> <u>Brookhaven, Miss.</u> (mailing address)			
	Clay	1	18
	sand & gravel	18	32
	white clay	32	50
	blue clay	50	132
	sand	132	182
WELL LOCATION:			
sec <u>29</u> T <u>7</u> S R <u>6</u> E W			
<u>9</u> miles <u>West</u> of <u>Brookhaven</u> (distance) (direction) (nearest town)			
WELL PURPOSE: <u>home</u> (home, irrigation, municipal, industrial)			
WELL COMPLETION DATA:			
(1) diameter (inches) <u>4</u>			
(2) total depth (feet) <u>182</u>			
(3) static water level (feet) <u>50</u> below top of ground.			
(4) casing <u>PVC</u> , <u>170</u> (material) (depth) <u>4"</u> (size) if telescope see back.			
(5) screen <u>12'</u> , <u>170'</u> (length) (depth to top) <u>.010</u> <u>PVC</u> (size) (material)			
(6) pump <u>3/4sub</u> , <u>10</u> (HP) (yield gpm)			
<u>Electricity</u> (type power)			
(7) electric log <u>no</u> (yes or no)			
<u>(organization running log)</u>			
(8) how well bottom plugged <u>back wash valve</u>			
DRILLERS REMARKS:			


Miss. Board of Water Comm.

JUL 9 1979

RECEIVED

If well telescopes please sketch and show depths.

GROUND LEVEL

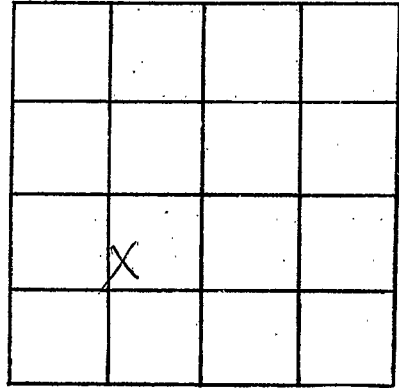

SECTION _____

Please indicate well location X.

ADDITIONAL INFORMATION

If more than one screen,
show locations of each on sketch.