

Lincoln
F 2016
10-15-80

MISSISSIPPI
BOARD OF WATER COMMISSIONERS
416 North State Street
Jackson, Mississippi 39201

WATER WELL DRILLERS LOG

Oct. 15 1980 Grenn Water Well Cont: Lincoln

date well completed firm name county well located

LANDOWNER: Hollis White
Route 2, Box 197
Brookhaven, Miss.
(mailing address)

description of formations encountered	from	to
Citronelle	1	64

WELL LOCATION:
sec. 23 T 7 N R 6 E
7 miles W of Brookhaven
(distance) (direction) (nearest town)

WELL PURPOSE: home
(home, irrigation, municipal, industrial)

WELL COMPLETION DATA:

(1) diameter (inches) 4

(2) total depth (feet) 65

(3) static water level (feet) 18 below above top of ground.

(4) casing pvc, 55'; (material), (depth), 4" (size) If telescope see back.

(5) screen 10' (length), 55' (depth to top) .010 PVC (size), (material)

(6) pump 1/2 sub 8 (HP), (yield gpm) electricity (type power)

(7) electric log no (yes or no) (organization running log)

(8) how well bottom plugged back was xh valve

DRILLERS REMARKS:


DEPT. OF NATURAL RESOURCES
BUREAU OF LAND & WATER RESOURCES

OCT 23 1980

RECEIVED

If well telescopes please sketch and show depths.

GROUND LEVEL

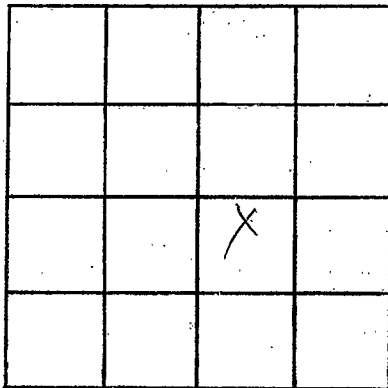

SECTION 23

Please indicate well location X.

ADDITIONAL INFORMATION

If more than one screen,
show locations of each on sketch.