

Lincoln
F 2017
11-18-80

MISSISSIPPI
BOARD OF WATER COMMISSIONERS
416 North State Street
Jackson, Mississippi 39201

WATER WELL DRILLERS LOG

11-18 1980 Grenn Water Well Cont. Lincoln
date well completed firm name county well located

LANDOWNER:	description of formations encountered	from	to
Willie Rice	Clay	1	35
Route 5, Box 146 A	sand & Gravel	35	75
Brookhaven, Miss.	white clay	75	120
(mailing address)	blue clay	120	130
WELL LOCATION:	white clay	130	135
sec. 34 T 7 N R 6 E	sand	135	170
8 miles W of Brookhaven			
(distance) (direction) (nearest town)			
WELL PURPOSE: home			
(home, irrigation, municipal, industrial)			
WELL COMPLETION DATA:			
(1) diameter (inches) 4			
(2) total depth (feet) 170			
(3) static water level (feet) 135 below top of ground.			
(4) casing PVC 160 (material) (depth)			
4" (size) if telescope see back.			
(5) screen 10' 160' (length) (depth to top)			
.010 PVC (size) (material)			
(6) pump did not install (HP) (yield gpm)			
(type power)			
(7) electric log no (yes or no)			
(organization running log)			
(8) how well bottom plugged back wash valve			
DRILLERS REMARKS:			


DEPT. OF NATURAL RESOURCES
BUREAU OF LAND & RELATED RESOURCES

JAN 12 1981

RECEIVED

If well telescopes please sketch and show depths.

GROUND LEVEL

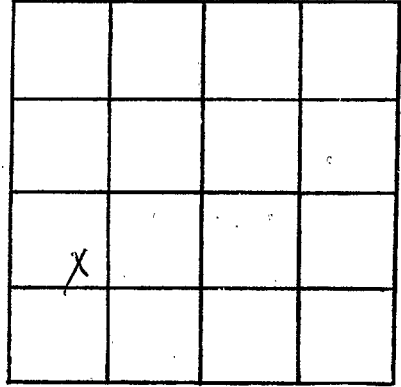

SECTION 34

Please indicate well location X.

ADDITIONAL INFORMATION

Lined area for additional information.

If more than one screen, show locations of each on sketch.