

Lincoln
F 2018
12-4-80

MISSISSIPPI
 BOARD OF WATER COMMISSIONERS
 416 North State Street
 Jackson, Mississippi 39201

WATER WELL DRILLERS LOG

Dec. 4 1980 Gretn Water Well Cont. Lincoln
 date well completed firm name county well located

LANDOWNER: Paul Smith
Route 2, Box 48
Brookhaven, Miss.
 (mailing address)

description of formations encountered	from	to
Clay	1	18'
sand & gravel	18	70
white clay	70	90
blue clay	90	210
sand	210	230

WELL LOCATION:
 sec. 11 T 7 N R 6 E
 S W
8 miles W of Brookhaven
 (distance) (direction) (nearest town)

WELL PURPOSE: home
 (home, irrigation, municipal, industrial)

WELL COMPLETION DATA:
 (1) diameter (inches) 4
 (2) total depth (feet) 230
 (3) static water level (feet) 140 below top of ground.
 (4) casing PVC 220
 (material) (depth)
4"
 (size) If telescope see back.
 (5) screen 10' 220"
 (length) (depth to top)
.010 PVC
 (size) (material)
 (6) pump 3/4 sub 10
 (HP) (yield gpm)
electricity
 (type power)
 (7) electric log no
 (yes or no)
(organization running log)

(8) how well bottom plugged back wash valve

DRILLERS REMARKS:


DEPT. OF NATURAL RESOURCES
 BUREAU OF LAND & WATER RESOURCES

JAN 20 1981

RECEIVED

If well telescopes please sketch and show depths.

GROUND LEVEL

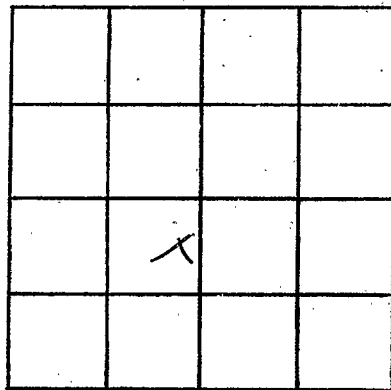

SECTION 11

Please indicate well location X.

ADDITIONAL INFORMATION

If more than one screen, show locations of each on sketch.