

Lincoln  
F2020  
3-9-81

MISSISSIPPI  
 BOARD OF WATER COMMISSIONERS  
 416 North State Street  
 Jackson, Mississippi 39201

WATER WELL DRILLERS LOG

March 9 1981 81 Grenn Water Well Cont. Lincoln

date well completed firm name county well located

LANDOWNER:	description of formations encountered	from	to
Barry Pickering	clay	1	25
Route 2, Box 123	sand & gravel	25	60
Brookhaven, Ms.	white clay	60	90
(mailing address)	blue clay	90	180
	sand	180	240
<b>WELL LOCATION:</b>			
sec. <u>20</u> T <u>7</u> N R <u>6</u> E			
	S W		
<u>8</u> miles <u>W</u> of <u>Brookhaven</u>			
(distance) (direction) (nearest town)			
<b>WELL PURPOSE:</b> <u>home</u>			
(home, irrigation, municipal, industrial)			
<b>WELL COMPLETION DATA:</b>			
(1) diameter (inches) <u>4</u>			
(2) total depth (feet) <u>240</u>			
(3) static water level (feet) <u>80</u> below top of ground.			
(4) casing <u>PVC</u> , <u>230</u> (material) (depth)			
<u>4"</u> (size) If telescope see back.			
(5) screen <u>10'</u> , <u>230'</u> (length) (depth to top)			
<u>.010</u> , <u>PVC</u> (size) (material)			
(6) pump <u>1/2 sub</u> <u>8</u> (HP) (yield gpm)			
<u>electricity</u> (type power)			
(7) electric log <u>no</u> (yes or no)			
(organization running log)			
(8) <u>how well bottom plugged</u> <u>back wash valve</u>			
<b>DRILLERS REMARKS:</b>			


DEPT. OF NATURAL RESOURCES  
 BUREAU OF LAND & WATER RESOURCES

JUN 5 - 1981

RECEIVED

If well telescopes please sketch and show depths.

GROUND LEVEL

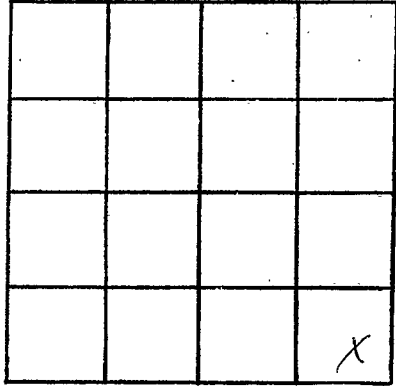

SECTION 20

Please indicate well location X.

ADDITIONAL INFORMATION

A series of horizontal lines for writing additional information.

If more than one screen, show locations of each on sketch.