

MISSISSIPPI DEPARTMENT OF NATURAL RESOURCES
Bureau of Land and Water Resources
 Southport Mall
 P.O. Box 10631
 Jackson, Mississippi 39209
WATER WELL DRILLERS LOG

Lincoln
F-2081
6-10-81

June 10 19 81 Green Water Well Cont. Lincoln
 date well completed firm name county well located

LANDOWNER: Norman Franklin

Rt. 2, Box 29A

Brookhaven, Ms.
 (mailing address)

description of formations encountered

from to

clay	1	15
sand & gravel	15	45
white clay	45	85
sand	85	150

WELL LOCATION:

sec 25 T 7 N R 6 E
 S W
6 miles SW of Brookhaven
 (distance) (direction) (nearest town)


WELL PURPOSE: home
 (home, irrigation, municipal, industrial)

WELL COMPLETION DATA:

- (1) diameter (inches) 4
- (2) total depth (feet) 150
- (3) static water level (feet) 65 below above top of ground.
- (4) casing PVC 140'
 (material) (depth)
4"
 (size) if telescope see back.
- (5) screen 10' 140'
 (length) (depth to top)
.010 PVC
 (size) (material)
- (6) pump 3/4 sub 8
 (HP) (yield gpm)
electricity
 (type power)
- (7) electric log no
 (yes or no)
(organization running log)


(8) how well bottom plugged
back wash valve

DRILLERS REMARKS:

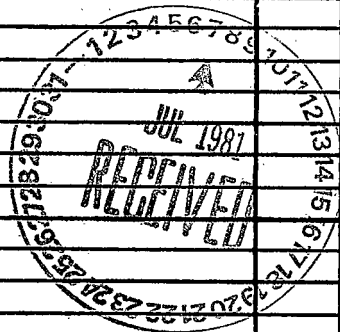

If well telescopes please sketch and show depths.

GROUND LEVEL

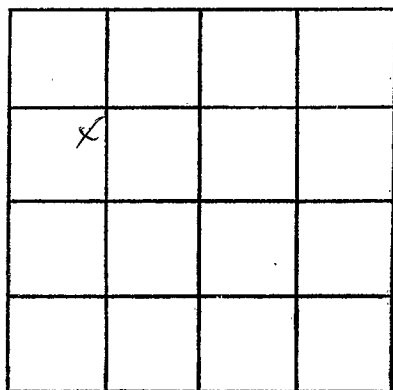

SECTION 25

Please indicate well location X.

ADDITIONAL INFORMATION

If more than one screen, show locations of each on sketch.