

Lincoln
F 2022
8/21/81

MISSISSIPPI DEPARTMENT OF NATURAL RESOURCES
 Bureau of Land and Water Resources
 Southport Mall
 P.O. Box 10631
 Jackson, Mississippi 39209
WATER WELL DRILLERS LOG

Aug 21 1981 Grenn Water Well Cont. Lincoln
 date well completed firm name county well located

LANDOWNER: Judy Applewhite description of formations encountered from to
Route 2, Box 36 Citronelle 1 84
Brookhaven, Miss.
 (mailing address)

WELL LOCATION:
 sec. 23 T. 7 N R. 6 E
7 miles W of Brookhaven
 (distance) (direction) (nearest town)

WELL PURPOSE: home
 (home, irrigation, municipal, industrial)


- WELL COMPLETION DATA:
- (1) diameter (inches) 4
 - (2) total depth (feet) 84
 - (3) static water level (feet) 50 below above top of ground.
 - (4) casing PVC 74
 (material) (depth)
4"
 (size) if telescope see back.
 - (5) screen 10' 74'
 (length) (depth to top)
.010 PVC
 (size) (material)
 - (6) pump did not install
 (HP) (yield gpm)
 (type power)
 - (7) electric log no
 (yes or no)
 (organization running log)
 - (8) how well bottom plugged back wash valve

DRILLERS REMARKS: _____

DEPT. OF NATURAL RESOURCES
 BUREAU OF LAND & WATER RESOURCES
 OCT - 1 1981
RECEIVED

If well telescopes please sketch and show depths.

GROUND LEVEL

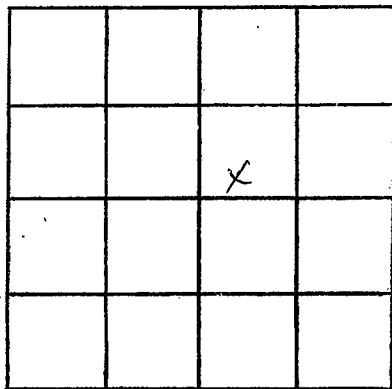

SECTION 23

Please indicate well location X.

ADDITIONAL INFORMATION

If more than one screen,
show locations of each on sketch.