

Lincoln
F
2026

MISSISSIPPI DEPARTMENT OF NATURAL RESOURCES
 Bureau of Land and Water Resources
 Southport Mall
 P.O. Box 10631
 Jackson, Mississippi 39209
WATER WELL DRILLERS LOG

Mar. 2 1982 Grenn Water Well Lincoln
 date well completed firm name county well located

LANDOWNER: Sam Colvin
 Rt. 2, Box 36
 Brookhaven, Ms
 (mailing address)

description of formations encountered	from	to
Sand & Gravel	1	12
White clay	12	60
Sand	60	74

WELL LOCATION:
 sec. 23 T 7 N R 6 E
 S W
6 miles West Brookhaven
 (distance) (direction) of (nearest town)

WELL PURPOSE: home
 (home, irrigation, municipal, industrial)

WELL COMPLETION DATA:


- (1) diameter (inches) 4
- (2) total depth (feet) 74
- (3) static water level (feet) 40 below above top of ground.
- (4) casing PVC 64
 (material) (depth)
4"
 (size) if telescope see back.
- (5) screen 10' 64'
 (length) (depth to top)
.010 PVC
 (size) (material)
- (6) pump did not install
 (HP) (yield gpm)
 (type power)
- (7) electric log no
 (yes or no)
 (organization running log)
- (8) how well bottom plugged back wash valve

DRILLERS REMARKS:

DEPT. OF NATURAL RESOURCES
 BUREAU OF LAND & WATER RESOURCES
 RECEIVED
 MAY 10 1982

If well telescopes please sketch and show depths.

GROUND LEVEL

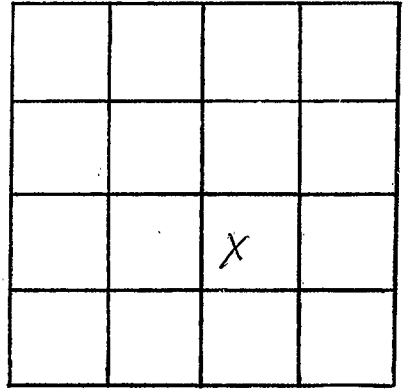

SECTION 23

Please indicate well location X.

ADDITIONAL INFORMATION

If more than one screen,
show locations of each on sketch.