

MISSISSIPPI DEPARTMENT OF NATURAL RESOURCES
Bureau of Land and Water Resources
 Southport Mall
 P.O. Box 10631
 Jackson, Mississippi 39209
WATER WELL DRILLERS LOG

Lincoln
E
227

Sept. 30 19 82 Green Water Well Lincoln
 date well completed firm name county well located

| LANDOWNER: <u>Willie Byrd</u> Rt. 5 | description of formations encountered <u>Citronelle</u> | from <u>1</u> | to <u>81</u> |
|---|--|------------------|-----------------|
| <u>Brookhaven, Ms.</u> (mailing address) | | | |
| WELL LOCATION: sec <u>9</u> T <u>N</u> R <u>6</u> E S W <u>8</u> miles <u>W</u> of <u>Brookhaven</u> (distance) (direction) (nearest town) | | | |
| WELL PURPOSE: <u>home</u> (home, irrigation, municipal, industrial) | | | |
| WELL COMPLETION DATA: | | | |
| (1) diameter (inches) <u>4</u> | | | |
| (2) total depth (feet) <u>81</u> | | | |
| (3) static water level (feet) <u>64</u> below above top of ground. | | | |
| (4) casing <u>PVC</u> , <u>71'</u> (material), (depth) <u>4"</u> if telescope see back. (size) | | | |
| (5) screen <u>10'</u> , <u>71'</u> (length), (depth to top) <u>.010</u> , <u>PVC</u> (size), (material) | | | |
| (6) pump <u>1/2</u> sub <u>8</u> (HP) (yield gpm) <u>electricity</u> (type power) | | | |
| (7) electric log <u>no</u> (yes or no) <u></u> (organization running log) | | | |
| (8) how well bottom plugged <u>back wash valve</u> | | | |
| DRILLERS REMARKS: <u></u> | | | |


DEPT. OF NATURAL RESOURCES
 BUREAU OF LAND & WATER RESOURCES

NOV 23 1982

RECEIVED

If well telescopes please sketch and show depths.

GROUND LEVEL

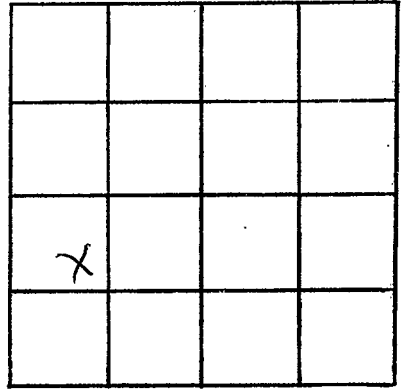

SECTION 9

Please indicate well location X.

ADDITIONAL INFORMATION

If more than one screen,
show locations of each on sketch.