

Lincoln  
F  
2034

MISSISSIPPI DEPARTMENT OF NATURAL RESOURCES  
Bureau of Land and Water Resources  
Southport Mall  
P.O. Box 10631  
Jackson, Mississippi 39209  
WATER WELL DRILLERS LOG

June 6<sup>1984</sup> date well completed      Grenn Water Well firm name      Lincoln county well located

LANDOWNER: A.L. Jolissant

P.O. Box 3125

Brookhaven, Ms.  
(mailing address)

description of formations encountered

Citronelle

from 1 to 80

WELL LOCATION:

sec. 35 T 7 N R 6 E  
S W  
7 miles SW of Brookhaven  
(distance) (direction) (nearest town)

WELL PURPOSE: home  
(home, irrigation, municipal, industrial)

WELL COMPLETION DATA:

- (1) diameter (inches) 4
- (2) total depth (feet) 80
- (3) static water level (feet) 39 below above top of ground.
- (4) casing PVC 70  
(material) (depth)  
4" if telescope see back.  
(size)
- (5) screen 10' 70  
(length) (depth to top)  
.010 PVC  
(size) (material)
- (6) pump 1/2 sub 8  
(HP) (yield gpm)  
electricity  
(type power)
- (7) electric log no  
(yes or no)

(organization running log)

(8) how well bottom plugged:  
back wash valve

DRILLERS REMARKS:


DEPT. OF NATURAL RESOURCES  
BUREAU OF LAND AND WATER RESOURCES

SEP 18 1984

RECEIVED

If well telescopes please sketch and show depths.

GROUND LEVEL

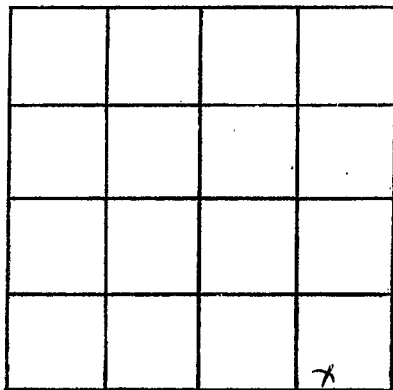

SECTION 35

Please indicate well location X.

ADDITIONAL INFORMATION

If more than one screen,  
show locations of each on sketch.