

Landers
F
2035

MISSISSIPPI DEPARTMENT OF NATURAL RESOURCES
 Bureau of Land and Water Resources
 Southport Mall
 P.O. Box 10631
 Jackson, Mississippi 39209
WATER WELL DRILLERS LOG

8-10 1984 Grenn Water Well Lincoln
 date well completed firm name county well located

LANDOWNER: Tommy Nettles
Rt. 2, Box 472
Brookhaven, Ms.
d (mailing address)

WELL LOCATION:
 sec. 25 T 7 N R 6 E
4 miles SW of Brookhaven
 (distance) (direction) (nearest town)

description of formations encountered	from	to
Clay	1	20
sand & gravel	20	60
white clay	60	80
blue clay	80	100
white clay	100	110
sand	110	151

WELL PURPOSE: home
 (home, irrigation, municipal, industrial)

WELL COMPLETION DATA:

(1) diameter (inches) 4

(2) total depth (feet) 151

(3) static water level (feet) 66 below above top of ground.

(4) casing PVC 141'
 (material) (depth)
4" if telescope see back.
 (size)

(5) screen 10' 141'
 (length) (depth to top)
.010 PVC
 (size) (material)

(6) pump 1/2 sub 8
 (HP) (yield gpm)
electricity
 (type power)

(7) electric log no
 (yes or no)
 (organization running log)

(8) how well bottom plugged:
back wash valve

DRILLERS REMARKS:


DEPT. OF NATURAL RESOURCES
 BUREAU OF LAND & WATER RESOURCES

SEP 18 1984

RECEIVED

If well telescopes please sketch and show depths.

GROUND LEVEL

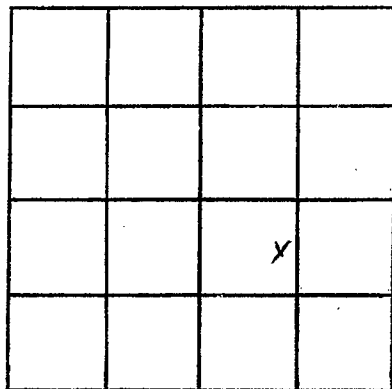

SECTION 25

Please indicate well location X.

ADDITIONAL INFORMATION

If more than one screen,
show locations of each on sketch.