

MISSISSIPPI DEPARTMENT OF NATURAL RESOURCES

Bureau of Land and Water Resources

Southport Mall <sup>u</sup>

P.O. Box 10631

Jackson, Mississippi 39209

WATER WELL DRILLERS LOG

|               |
|---------------|
| <i>Lucien</i> |
| <i>F</i>      |
| <i>2036</i>   |
| <i>10-16</i>  |

June 15 19 84 Green Water Well Lincoln  
 date well completed firm name county well located


| LANDOWNER: <u>Will Jordan</u><br><u>Herschel Adams</u>   | description of formations encountered | from | to |
|--|---------------------------------------|------|----|
| <u>Route 2</u><br><u>Brookhaven, Ms.</u><br>(mailing address)  |                                       |      |    |
| WELL LOCATION:<br>sec <u>14</u> T <u>7</u> N R <u>6</u> E<br>S W<br><u>5</u> miles <u>W</u> of <u>Brookhaven</u><br>(distance) (direction) (nearest town)  |                                       |      |    |
| WELL PURPOSE: <u>home</u><br>(home, irrigation, municipal, industrial)   |                                       |      |    |
| WELL COMPLETION DATA:<br>(1) diameter (inches) <u>4</u><br>(2) total depth (feet) <u>135</u><br>(3) static water level (feet) <u>92</u> below above top of ground.<br>(4) casing <u>PVC</u> , <u>125</u> ,<br>(material) (depth),<br><u>4"</u> if telescope see back.<br>(size)<br>(5) screen <u>10"</u> , <u>125"</u><br>(length) (depth to top)<br><u>010</u> , <u>PVC</u> ,<br>(size) (material)<br>(6) pump <u>1/2</u> <u>8</u><br>(HP) (yield gpm)<br><u>electricity</u><br>(type power)<br>(7) electric log <u>no</u><br>(yes or no)<br><u>(organization running log)</u><br>(8) how well bottom plugged<br><u>back wash valve</u> |                                       |      |    |
| DRILLERS REMARKS:  |                                       |      |    |

DEPT. OF NATURAL RESOURCES  
 BUREAU OF LAND & WATER RESOURCES

NOV 15 1984  
 RECEIVED

If well telescopes please sketch and show depths.

GROUND LEVEL

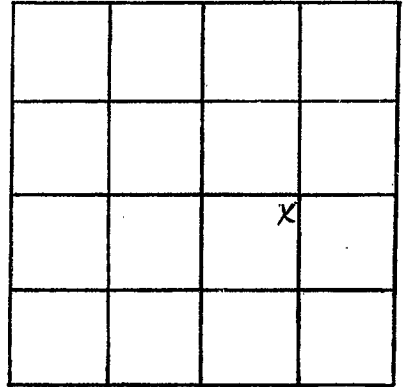

SECTION 14

Please indicate well location X.

ADDITIONAL INFORMATION

If more than one screen,  
show locations of each on sketch.